

WELL PLUGGING RECORD


STATE OF KANSAS
STATE CORPORATION COMMISSION

Give All Information Completely
Make Required Affidavit
Mail or Deliver Report to:
Conservation Division
State Corporation Commission
800 Bitting Building
Wichita, Kansas

OR FORMATION PLUGGING RECORD

Strike out upper line
when reporting plug-
ging off formations.

Stafford County. Sec. 20 Twp. 21 Rge. 12 (B) (W)
 Location as "NE $\frac{1}{4}$ NW $\frac{1}{4}$ SW $\frac{1}{4}$ " or footage from lines SE NE NW
 Lease Owner Anschutz Drilling Company, Inc.
 Lease Name Hall Well No. 3
 Office Address 709 Union National Bk Bldg., Wichita, Kansas
 Character of Well (completed as Oil, Gas or Dry Hole) Dry Hole
 Date well completed 2-7 19 50
 Application for plugging filed via telephone 2-7 19 50
 Application for plugging approved via telephone 2-7 19 50
 Plugging commenced 2-7 19 50
 Plugging completed 2-7 19 50
 Reason for abandonment of well or producing formation Dry

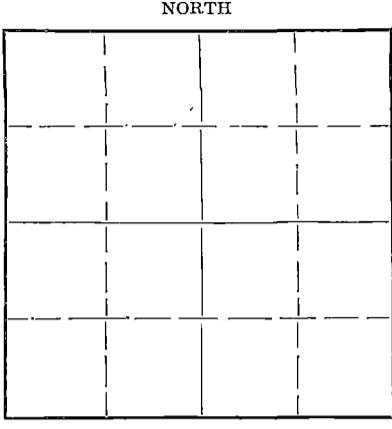

Locate well correctly on above Section Plat

If a producing well is abandoned, date of last production 19...
 Was permission obtained from the Conservation Division or its agents before plugging was commenced? yes C. D. Stough
 Name of Conservation Agent who supervised plugging of this well C. D. Stough
 Producing formation Depth to top Bottom Total Depth of Well 3652 Feet
 Show depth and thickness of all water, oil and gas formations.

OIL, GAS OR WATER RECORDS CASING RECORD

Formation	Content	From	To	Size	Put In	Pulled Out
				8-5/8"	315'	-

Describe in detail the manner in which the well was plugged, indicating where the mud fluid was placed and the method or methods used in introducing it into the hole. If cement or other plugs were used, state the character of same and depth placed, from...feet to...feet for each plug set.

Bottom plug set at 315' with 15 sacks cement
 Top plug set at 50' with 10 sacks cement

2-13-50
 FEB 13 1950
 STATION


(If additional description is necessary, use BACK of this sheet)
 Correspondence regarding this well should be addressed to Anschutz Drilling Company, Inc.
 Address 709 Union National Bank Building, Wichita, Kansas

STATE OF KANSAS, COUNTY OF SEDGWICK, ss.
 H. R. Jensen (employee of owner) or (owner or operator) of the above-described well,
 being first duly sworn on oath, says: That I have knowledge of the facts, statements, and matters herein contained and the log of the above-described well as filed and that the same are true and correct. So help me God.

(Signature) H. R. Jensen
 709 Union Nat'l Bk Bldg., Wichita, Kansas
 (Address)

SUBSCRIBED AND SWORN TO before me this 11th day of February, 19 50

My commission expires September 12, 1953
 Notary Public.

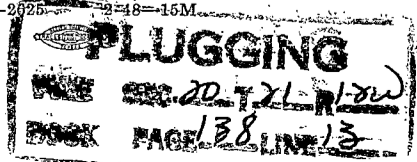

WELL LOG

ANSCHUTZ DRILLING COMPANY, INC.

Hall #3 SE NE NW 20-21-12
Stafford County, Kansas

COMMENCED: 1-27-50
COMPLETED: 2-7-50

0	100	Sand
100	240	Sand
240	295	Red Bed and sand
295	335	Red Bed
335	490	Red Bed
490	670	Red Bed
670	690	Anhydrite
690	825	Shale and shells
825	1045	Shale and shells
1045	1225	Shale and shells
1225	1420	Shale and salt
1420	1525	Shale and lime
1525	1665	Lime
1665	1840	Lime and shale
1840	1975	Shale and lime
1975	2065	Shale and lime
2065	2165	Lime and shale
2165	2335	Shale and lime
2335	2500	Shale and lime
2500	2635	Shale and lime
2635	2745	Shale and lime
2745	2882	Shale and lime
2882	2999	Lime broken
2999	3055	Lime
3055	3110	Lime
3110	3155	Lime
3155	3200	Shale
3200	3272	Shale
3272	3307	Lime
3307	3332	Lime
3332	3400	Lime
3400	3451	Lime
3451	3501	Lime
3501	3542	Lime
3542	3576	Viola
3576	3588	Viola lime
3588	3622	Shale
3622	3652	Shale
3652		Rotary Total Depth

CASING RECORD
Set 8-5/8" surface casing at
315', cemented with 200
sacks cement by Sun.

RECEIVED
Conservation Div.
FEB 13 1950
STATE CONSERVATION
COMMISSION
KANSAS

STATE OF KANSAS)
) SS
COUNTY OF SEDGWICK)

I hereby affirm that the above and foregoing is a true and correct copy of the log of the #3 Hall located SE NE NW 20-21-12, Stafford County, Kansas.

ANSCHUTZ DRILLING COMPANY, INC.

By: *H. R. Jensen*

Subscribed and sworn to before me this 11th day of February, 1950.

Martha Boyer
Notary Public

My commission expires September 12, 1953

PLUGGING
SEC 20 T 21 R 12 W
PAGE 138 LINE 13