

STATE OF KANSAS
STATE CORPORATION COMMISSION


WELL PLUGGING RECORD

Give All Information Completely
Make Required Affidavit
Mail or Deliver Report to:
Conservation Division
State Corporation Commission
800 Bitting Building
Wichita, Kansas

OR
FORMATION PLUGGING RECORD

Strike out upper line
when reporting plug-
ging off formations.

NORTH

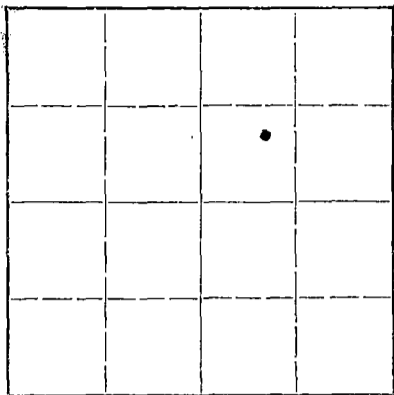

Locate well correctly on above
Section Plat

Stafford County. Sec. 20 Twp. 21 Rge. (E) 12 (W)
Location as "NE $\frac{1}{4}$ NW $\frac{1}{4}$ SW $\frac{1}{4}$ " or footage from lines NE/4 SW/4 NE/4
Lease Owner Stanolind Oil and Gas Company
Lease Name H. Tieperman "B" Well No. 2
Office Address Box 1654 Oklahoma City, Oklahoma
Character of Well (completed as Oil, Gas or Dry Hole) Dry Hole
Date well completed May 10 19 48
Application for plugging filed May 12 19 48
Application for plugging approved May 12 19 48
Plugging commenced May 10 19 48
Plugging completed May 10 19 48
Reason for abandonment of well or producing formation Well completed as a dry hole.

If a producing well is abandoned, date of last production 19
Was permission obtained from the Conservation Division or its agents before plugging was com-
menced? YES

Name of Conservation Agent who supervised plugging of this well Mr. C. D. Stough, Great Bend, Kansas
Producing formation Arbuckle Depth to top 3586 Bottom 3710 Total Depth of Well 3710 Feet
Show depth and thickness of all water, oil and gas formations.

OIL, GAS OR WATER RECORDS

CASING RECORD

Formation	Content	From	To	Size	Put In	Pulled Out
				8-5/8"	686'	None
Top Iatan		3244				
Top Lansing		3261				
Top Viola		3476				
Top Simpson		3502				
Top Arbuckle		3586	3710			

Describe in detail the manner in which the well was plugged, indicating where the mud fluid was placed and the method or methods used in introducing it into the hold. If cement or other plugs were used, state the character of same and depth placed, from feet to feet for each plug set.

3710 - 670 Heavy Mud
670 - 623 15 Sax cement
623 - 30 Heavy Mud
30 - 0 10 Sax Cement

(If additional description is necessary, use BACK of this sheet)



Correspondence regarding this well should be addressed to Mr. T. L. Regan
Address Box 1654 Oklahoma City, Oklahoma

STATE OF Kansas, COUNTY OF Barton, ss.
H. G. Nething (employee of owner) or (owner or operator) of the above-described well,
being first duly sworn on oath, says: That I have knowledge of the facts, statements, and matters herein contained and the log of the above-described well as filed and that the same are true and correct. So help me God.

(Signature) *H. G. Nething* Field Supt.
Box 7, Ellinwood (Address)

SUBSCRIBED AND SWORN TO before me this 21 day of June

My commission expires October 18, 1950

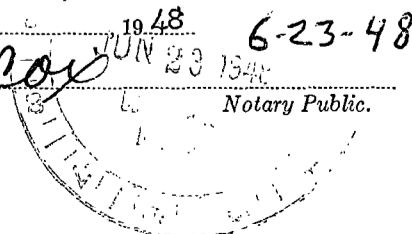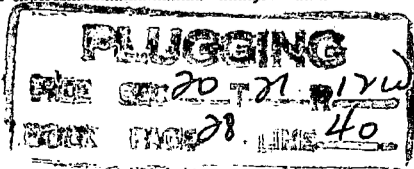

FORMATION RECORD

DESCRIBE EACH FORMATION DRILLED. INDICATE THICKNESS, CONTENT AND WHETHER DRY, OR OIL, GAS, OR WATER BEARING.

FORMATION	TOP	BOTTOM	FORMATION	TOP	BOTTOM
Sand & Clay	0	230			
Shale and Shells	230	580			
Shale and Shells	580	675			
Top Anhydrite	675				
Anhydrite	675	705			
Shale	705	965			
Shale and shells	965	1705			
Lime	1705	2093			
Lime	2093	2176			
Shale and Shells	2176	2470			
Broken Lime	2470	2598			
Shale and Shells	2598	2870			
Broken Lime	2870	2935			
Lime	2935	3205			
Lime and shale	3205	3261			
Top Lansing	3261				
Lime	3261	3355			
Lime and shale	3355	3408			
Lime	3408	3476			
Top Viola	3476				
Lime	3476	3502			
Top Simpson	3502				
Lime	3502	3545			
Lime and shale	3545	3572			
Lime	3572	3586			
Top Arbuckle	3586				
Lime	3586	3592			
Lime and shale	3592	3620			
Blue Shale	3620	3626			
Lime	3626	3631			
Lime	3631	3710			
Schlumberger Electric Log To	T.D.				
Total Depth					
By Schlumberger		3680			
By Rotary Drill		3680			
8-5/8" OD Casing Set @		686			
W/400 Sax cement					
Total Depth		3710			
Completed:					
As a dry hole May 11, 1948					

PLUGGING

STANOLIND OIL AND GAS COMPANY

WELL RECORD

TWP. 21 S N OR S

SUPPLEMENTAL (ENTER "X" WHEN APPLICABLE)

Grid for well location with 'X' in section 20, township 21, range 12.

LEASE H. Tieperman "B" WELL NO. 2

LOCATION OF WELL: 1650 FT. NORTH SOUTH OF THE NORTH SOUTH LINE AND 1650 FT.

EAST WEST EAST WEST LINE OF THE C/NE SW NE

OF SECTION 20 TOWNSHIP 21 NORTH SOUTH. RANGE 12 EAST WEST.

Stafford Kansas COUNTY STATE

ELEVATION: 1859 D.F.

COMPLETED AS: OIL WELL GAS WELL WATER WELL DRY HOLE

DRILLING: COMMENCED April 22 19 48 COMPLETED May 11 19 48

LOCATE WELL CORRECTLY

OPERATING COMPANY Stanolind Oil and Gas Company ADDRESS Box 1654, Oklahoma City, Oklahoma

OIL OR GAS SANDS OR ZONES

Table with columns: NAME, FROM, TO, NAME, FROM, TO. Rows for Lansing, Viola, Simpson, Arbuckle.

WATER SANDS

Table with columns: NAME, FROM, TO, WATER LEVEL, NAME, FROM, TO, WATER LEVEL. Rows 1 and 2.

CASING RECORD (OVERALL MEASUREMENT)

LINER-SCREEN RECORD

Tables for casing and liner-screen records with columns for size, weight, quantity, etc.

PACKER RECORD

Table for packer record with columns for size, length, set at, make and type.

CEMENTING RECORD

MUDDING RECORD

Tables for cementing and mudding records with columns for size, where set, cement, method, final press, etc.

WHAT METHOD WAS USED TO PROTECT SANDS WHEN OUTER STRINGS WERE PULLED?

WERE BOTTOM HOLE PLUGS USED?

IF SO, STATE KIND, DEPTH SET, AND RESULTS OBTAINED

ROTARY TOOLS WERE USED FROM 0 FEET TO 3710 FEET, AND FROM FEET TO FEET

CABLE TOOLS WERE USED FROM FEET TO FEET, AND FROM FEET TO FEET

24-HOUR PRODUCTION OR POTENTIAL TEST

WATER BBLs.

IF GAS WELL, CUBIC FEET PER 24 HOURS SHUT-IN PRESSURE LBS. PER SQUARE IN.

I, THE UNDERSIGNED, BEING FIRST DULY SWORN UPON OATH, STATE THAT THIS WELL RECORD IS TRUE AND CORRECT...

SUBSCRIBED AND SWORN TO BEFORE ME THIS 28th DAY OF May 1950

MY COMMISSION EXPIRES

Notary signature and title: Field Supt.

Notary Public signature and title.