

15.159.05292.0000

STATE OF KANSAS  
STATE CORPORATION COMMISSION


WELL PLUGGING RECORD

Give All Information Completely  
Make Required Affidavit  
Mail or Deliver Report to  
Conservation Division  
State Corporation Commission  
800 Bittling Building  
Wichita, Kansas

OR  
FORMATION PLUGGING RECORD

Strike out upper line  
when reporting plugging  
off formations.

NORTH

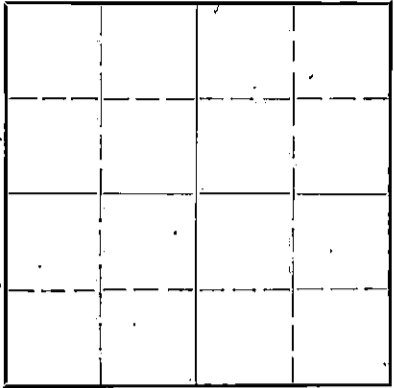

Locate well correctly on above  
Section Plat

Rice County, Sec. 5 Twp. 21 Rge. (E) 7 (W)  
Location as "NE 1/4 NW 1/4 SW 1/4" or footage from lines SE 1/2 of the SW 1/2

Lease Owner El Dorado Refining Company

Lease Name Gossman Well No. 4

Office Address El Dorado, Kansas

Character of Well (completed as Oil, Gas or Dry Hole) Dry hole oil well

Date well completed 19

Application for plugging filed 19

Application for plugging approved Sept. 13, 19 44

Plugging commenced Oct. 28 19 44

Plugging completed Nov. 6 19 44

Reason for abandonment of well or producing formation Dry Hole Estimated oil well

If a producing well is abandoned, date of last production 19

Was permission obtained from the Conservation Division or its agents before plugging was commenced? yes

Name of Conservation Agent who supervised plugging of this well Ruel Durkee

Producing formation Depth to top Bottom Total Depth of Well 3347 Feet

Show depth and thickness of all water, oil and gas formations.

OIL, GAS OR WATER RECORDS

CASING RECORD

Formation	Content	From	To	Size	Put In	Pulled Out
				12 1/2"	107'	107' left in well
				7"	3320'	3320' 2362ft
				5 1/2" liner	30'	30' left in well

Describe in detail the manner in which the well was plugged, indicating where the mud fluid was placed and the method or methods used in introducing it into the hold. If cement or other plugs were used, state the character of same and depth placed, from feet to feet for each plug set.

Mud to 3330' and run 6 sacks cement from 3330' to 3300'  
Mud from 3300' to 155' bridge with rock to 150'  
Run 30 sacks cement from 150' to 120'  
Fill with mud from 120' to 15'  
Cap with 10 sacks cement from 15' to cellar base

5 21 7W  
131 10

(If additional description is necessary, use BACK of this sheet)

Correspondence regarding this well should be addressed to El Dorado Refining Company, El Dorado, Kansas


STATE OF Kansas COUNTY OF Reno

being first duly sworn on oath, says: That I have knowledge of the facts, statements, and matters herein contained and the log of the above described well as filed and that the same are true and correct. So help me God.

NOT SIGNED FOR NOTARIZED  
(Signature) Lewis B. Sherman, Notary Public  
Hutchinson, Kansas NOV 20 1944

SUBSCRIBED AND SWORN to before me this 13th day of November, 1944

My commission expires Jan 19-1946

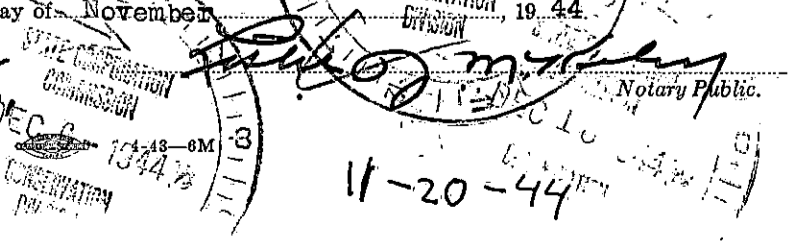

11-20-44


WELL LOG BUREAU - KANSAS GEOLOGICAL SOCIETY  
412 Union National Bank Bldg., Wichita, Kansas

ELDORADO REFINING CO.  
Louis Gossman No. 4

SEC 5 T. 21 R. 7W  
SE SW

Total Depth. 3347  
Comm. 12-5-39 Comp. 12-27-39  
Shot or Treated.  
Contractor. Stearns-Walker Drilling Co.  
Issued. 1-13-40

County Rice.

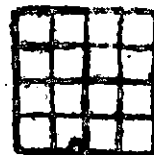


CASING.

12 1/2" 107 Elevation.  
7" 3320'  
run 30' 1" of 53/16 liner at 3332 1/2' Production Pot. 364B.  
Figures Indicate Bottom of Formations.

cellar	10	
sand	69	
shale and shells	90	
red bed and shells	107	
shale and shells	440	
red bed, green shale and shells	635	
salt	798	
shale and lime shells	1063	
broken lime	1179	
broken lime and shale	1287	
broken lime	1346	
sdv shale and lime	1375	
Florence Flint	1392	
lime	1473	
shale and shells	1915	
shale	2067	
shale and shells	2405	
broken lime	2448	
Topeka lime	2457	
lime	2593	
broken lime	2650	
lime	2718	
broken lime	2735	
shale and shells	2887	
lime	2991	
lime soft porous	3003	
limo	3211	
shale	3216	
broken lime	3262	
shale and shells	3319	standard tools 3319
lime and red rock	3329	
red rock and lime	3332 1/2	
conglomerate and oil	3347	
Total Depth.		

run 30 ft 1 in. of 53/16 liner at 3332 1/2

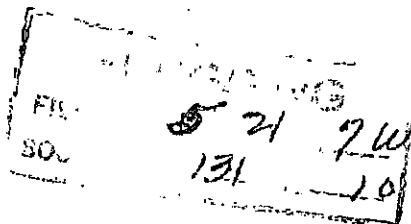

ESTD