

STATE OF KANSAS
STATE CORPORATION COMMISSION


WELL PLUGGING RECORD

OR
FORMATION PLUGGING RECORD

Strike out upper line
when reporting plug-
ging off formations.

Give All Information Completely
Make Required Affidavit
Mail or Deliver Report to:
Conservation Division
State Corporation Commission
800 Bittling Building
Wichita, Kansas

NORTH

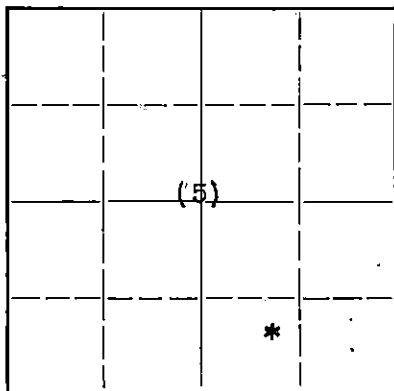

Locate well correctly on above
Section Flat

Rice County, Sec. 5 Twp. 21 Rge. (E) 7 (W)
Location as "NE 1/4 NW 1/4 SW 1/4" or footage from lines 660N-998E of S/4 corner
Lease Owner Cities Service Oil Company
Lease Name Gossman Well No. 2
Office Address Bartlesville, Oklahoma
Character of Well (completed as Oil, Gas or Dry Hole) Oil
Date well completed January 16, 1943
Application for plugging filed January 16, 1943
Application for plugging approved January 16, 1943
Plugging commenced January 22, 1943
Plugging completed January 31, 1943
Reason for abandonment of well or producing formation Non Commercial
If a producing well is abandoned, date of last production October 31, 1943
Was permission obtained from the Conservation Division or its agents before plugging was com-
menced? YES

Name of Conservation Agent who supervised plugging of this well Ruel Durkee
Producing formation Conglomerate Depth to top 3332 Bottom Total Depth of Well 3411 Feet
Show depth and thickness of all water, oil and gas formations.

OIL, GAS OR WATER RECORDS


CASING RECORD

Formation	Content	From	To	Size	Put In	Pulled Out
	Cemented w/	150 Sx.		10 3/4"	128'	None
	Cemented w/	75 Sx.		7"	3333'	2792'
				5 1/2"	67'	None

Describe in detail the manner in which the well was plugged, indicating where the mud fluid was placed and the method or methods used in introducing it into the hold. If cement or other plugs were used, state the character of same and depth placed, from _____ feet to _____ feet for each plug set.

34 Sx. Cement 3411' to 3264'
Heavy Mud 3264' to 160'
Wood Plug 160' to 158'
15 Sx. Cement 158' to 128'
Heavy Mud 128' to 12'
5 Sx. Cement 12' to Base of Cellar

Pipe cut off and cap welded on top.

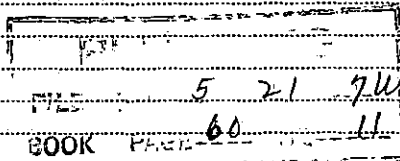

(If additional description is necessary, use BACK of this sheet)

Correspondence regarding this well should be addressed to R. C. Hauber
Address Cities Service Oil Company Great Bend, Kansas

STATE OF Kansas, COUNTY OF Barton, ss.
Opposite (employee of owner) or (owner or operator) of the above-described well,

being first duly sworn on oath, says: That I have knowledge of the facts, statements, and matters herein contained and the log of the above-described well as filed and that the same are true and correct. So help me God.

(Signature) S. P. Gatos

(Address)

SUBSCRIBED AND SWORN to before me this 6 day of February 19 43

(Signature) C. B. Busby
Notary Public.

My commission expires My Commission Expires Sept. 26, 1946

WELL RECORD

Company Cities Service Oil Co. No. 2 Farm Gossman

Location 660' N & 938' E of 3/4 Cor. Sec. 5 T. 21 R. 7-N

Elevation 1617 County Rice State Kansas

Drig. Comm. Nov. 30, 1939 Phys. Potential: 32 oil

Date Completed Jan. 16, 1940 Initial Production and 2% water, 24 hrs.

Contractor: M. B. Maboo Company

Total Depth 3411'

CASING RECORD:

10-3/4" 128' con. 150 cement & 5 Aquangel
 7" OD 3333' con. 75 Ash Grove & 40 Aquangel
 5 1/2" Liner 57' set at 3344' with Lane-Wells
 liner hanger

FORMATION RECORD:

sand 0-90
 red bed & shells 126
 shale & shells 643
 salt & shale 850
 shale & shells 1053
 lime broken 1125
 shale 1153
 lime & shale 1310
 shale 1352
 shale & lime 1630
 shale & shells 2328
 lime broken 2354
 shale & lime 2560
 lime 2640
 broken lime 2690
 lime 2738
 lime broken 2816
 lime 2833
 shale 2877
 shale & lime 2930
 lime 3039
 shale & lime 3093
 lime 3153
 lime & shale 3257
 lime broken 3302
 lime & shale 3331
 shale 3333
 conglomerate 3334

Top Conglomerate 3333
 3334 Rotary T.D. = 3333 SIM
 Corr. top Conglomerate 3332

chert 3336
 red bed 3343
 chert 3345
 conglomerate 3350
 chert & sand 3354
 chert, & sand, hard 3368
 chert & sand, soft 3373
 chert & sand, hard 3377

chert & sand, med. 3380
 chert, sand, red rock, soft 3384
 red rock, soft 3389
 chert, red rock 3392
 chert, shale, red rock, lime 3393
 chert & shale 3398
 sand & shale 3402
 chert & sandy shale 3411 T. D.

Corr. Top Conglomerate 3338
 Penetration Conglomerate 55'
 Top Mississippi 3337
 Top Kinderhook 3406
 Total Depth 3411

At 3350' pumped 37 bbls. oil
 first day; 2nd day pumped 26
 bbls. and pumped off.

Rotary G-1533 SIM
 Cable Tools 3333-3411

SYFO: 250' 00
 530' 00
 600' 00
 1000' 00
 1350' 00
 1800' 00
 2300' 10
 2800' 00

5 21 7 W
 60

15.159.05286.0000



CITIES SERVICE OIL COMPANY

PRODUCERS-REFINERS-MARKETERS OF PETROLEUM PRODUCTS

**BARTLESVILLE
OKLAHOMA**

Great Bend, Kansas
February 4, 1943

State Corporation Commission
Conservation Division
800 Bitting Building
Wichita, Kansas

Gentlemen:

Attached is Well Plugging Record covering
the abandonment of our Gossman well No. 2, Section
5-21-7W, Rice County, Kansas.

Yours very truly,

CITIES SERVICE OIL CO.

R. C. Hauber

EH:
Attach.

PLUGGING
FILE 5 21-7W
BOOK PAGE 60 15-11

STATE CORPORATION
COMMISSION
FEB 5 - 1943