


STATE OF KANSAS
STATE CORPORATION COMMISSION

Give All Information Completely
Make Required Affidavit
Call or Deliver Report to:
Conservation Division
State Corporation Commission
800 Bitting Building
Wichita, Kansas

WELL PLUGGING RECORD
OR
FORMATION PLUGGING RECORD

Strike out upper line
when reporting plug-
ging off formations.

NORTH

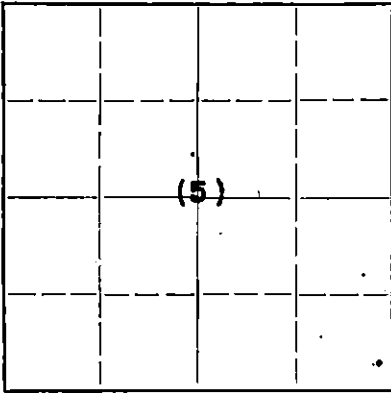

Locate well correctly on above
Section Plat

Rice County, Sec. 5 Twp. 21 Rge. 7 (E) 7 (W)
Location as "NE 1/4 NW 1/4 SW 1/4" or footage from lines 330N-184' W of SE Corner
Lease Owner Cities Service Oil Company
Lease Name Gossman Well No. 1
Office Address Bartlesville, Oklahoma
Character of Well (completed as Oil, Gas or Dry Hole) Oil Well
Date well completed August 14, 19 37
Application for plugging filed July 24, 19 42
Application for plugging approved July 27, 19 42
Plugging commenced July 31, 19 42
Plugging completed August 8, 19 42
Reason for abandonment of well or producing formation Non Commercial
If a producing well is abandoned, date of last production April 1, 19 42
Was permission obtained from the Conservation Division or its agents before plugging was com-
menced? YES

Name of Conservation Agent who supervised plugging of this well Roul Durkee
Producing formation Chert Conglomerate Depth to top 3334 Bottom 3357 Total Depth of Well 3357 Feet
Show depth and thickness of all water, oil and gas formations.

OIL, GAS OR WATER RECORDS


CASING RECORD

Formation	Content	From	To	Size	Put In	Pulled Out
	Cemented with	135 sacks	12 1/2"	110'	none	
	Cemented with	230 sacks	7"	3337'	2304'	
	Liner	5 1/2"	64'	none		

Describe in detail the manner in which the well was plugged, indicating where the mud fluid was placed and the method or methods used in introducing it into the hold. If cement or other plugs were used, state the character of same and depth placed, from.....feet to.....feet for each plug set.

12 sacks cement 3357' to 3267'
3267' to 150' Heavy Mud
20 sacks cement 150' to 130'
130' to 10' Heavy Mud
8 sacks cement 10' to Base of Celler

5 21 7W
44 6

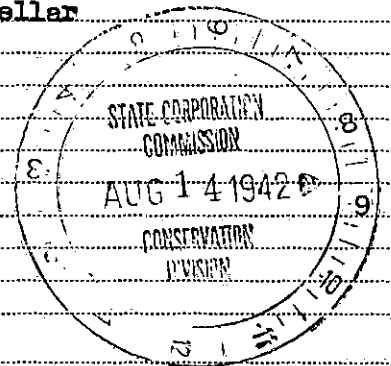

(If additional description is necessary, use BACK of this sheet)

Correspondence regarding this well should be addressed to R. C. Hauber
Address Cities Service Oil Company
Great Bend, Kansas

STATE OF Kansas COUNTY OF Barton, ss.
(employee of owner) or (owner or operator) of the above-described well,
being first duly sworn on oath, says: That I have knowledge of the facts, statements, and matters herein contained and the log of the above-described well as filed and that the same are true and correct. So help me God.

(Signature) *[Signature]*

(Address)

SUBSCRIBED AND SWORN to before me this 13 day of Aug 19 42

My commission expires My Commission Expires Sept. 26, 1942 Notary Public.

WELL RECORD

Company Cities Service Oil Co. Well No. 1 Farm Gossman
 Location 330' north and 184' west of SE Corner Sec. 5 T. 21 R. 7-N
 Elevation _____ County Rice State Kansas
 Drlg. Comm. July 23, 1937 Contractor H. J. Shaffer Drilling Co.
 Drlg. Comp. August 14, 1937 Acid None
 T. D. 3358' Initial Prod. 555 oil, 24 hours - natural

CASING RECORD:

12-1/2" 110' cem. 135 sacks Lone Star
 7" 3337' cem. 230 sacks
 5-3/16" 64'3" liner at 3351' SLM

Top Cherty Cong. 3334'
 Penetration 24'
 Total Depth 3358' SLM


FORMATION RECORD:

sand & gravel 65
 red rock & shells 77
 shale & shells 114
 sand & gravel 125
 sandy shale 344
 shale & shells 1030
 shale & lime 1065
 shells 1158
 shale, lime & shells 1288
 broken lime 1420
 sandy lime 1523
 broken lime 1650
 shale & shells 1810
 sandy shale & shells 2155
 shale & lime 2270
 sandy shale & shells 2405
 lime 2415
 broken lime 2530
 lime 2775
 broken lime 2837
 shale & lime 2912
 lime 2972
 lime & iron pyrite 3000
 lime hard 3045
 lime 3154
 lime hard 3164
 lime 3278
 broken lime 3320
 lime & shale 3325
 variegated shale 3329
 conglomerate 3332
 SLM Corr. 3332 = 3337
 conglomerate 3351
 red rock 3357
 conglomerate 3362
 chert 3363

S.O. and gas 3340-3342'
 Inc. in oil 3342-3346'

Perforated with Lane-Wells gun
 from 3340-45 with 150 shots -
 August 24, 1937.

PLUGGING
 FILE SEC. 5 21.27.11
 BOOK PAGE 44 NE--6--

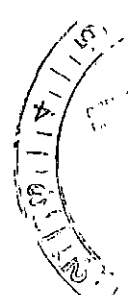

Corr. SLM 3363 = 3358