

NOTICE OF INTENTION TO DRILL

(see rules on reverse side)

Starting Date 9/11/85
 month day year 11:30

API Number 15— 097-21, 183-0000

OPERATOR: License # 5992 app.
 Name ... Patton Oil Company
 Address 5660 S. Syracuse Cir. #220
 City/State/Zip ... Englewood, CO 80111
 Contact Person John W. Smith
 Phone 303.773.6016

..... NW ~~SE~~ NW SE Sec. 13 .. Twp. 28. S, Rg. 19. X West
 2100 Ft. from South Line of Section
 2310 Ft. from East Line of Section

(Note: Locate well on Section Plat on reverse side)

CONTRACTOR: License # 6033
 Name Murfin Drilling Company

City/State .. 250 N. Water, Suite 300, Wichita, KS 67202

Well Drilled For: Well Class: Type Equipment:
 Oil SWD Infield Mud Rotary
 Gas Inj Pool Ext. Air Rotary
 OWWO Expl Wildcat Cable

Nearest lease or unit boundary line .. 330 feet
 County Kiowa

Lease Name Hendershot "A" Well # ... 1

Ground surface elevation 2240 feet MSL

Domestic well within 330 feet: yes no

Municipal well within one mile: yes no

Surface pipe by Alternate: 1 2

Depth to bottom of fresh water 125

Depth to bottom of usable water 200

Surface pipe planned to be set 500

Projected Total Depth 4875 feet

Formation Mississippi

If OWWO: old well info as follows:

Operator
 Well Name
 Comp Date Old Total Depth

I certify that well will comply with K.S.A. 55-101, et seq., plus eventually plugging hole to KCC specifications.

_____ cementing will be done immediately upon setting production casing.

Date ... 9/10/85 Signature of Operator or Agent Elaine Bauman Title ... as agent

RCR for KOWE

For KCC Use:

Conductor Pipe Required feet; Minimum Surface Pipe Required feet per App. 1 2

This Authorization Expires 3-10-86 Approved By 9-10-85- R

Must be filed with the K.C.C. five (5) days prior to commencing well
This card void if drilling not started within six (6) months of date received by K.C.C.

Important procedures to follow:

1. Notify District office before setting surface casing.
2. Set surface casing by circulating cement to the top.
3. File completion forms ACO-1 with K.C.C. within 90 days of well completion, following instructions on ACO-1, side 1, and including copies of wireline logs.
4. Notify District office 48 hours prior to old well workover or re-entry.
5. Prior to filing Intent, prepare a proposed plugging plan in case well is D & A, then obtain approval of plan when calling district office prior to setting surface pipe.
6. Submit plugging report (CP-4) to K.C.C. after plugging is completed.
7. Obtain an approved injection docket number before disposing of salt water.
8. Notify K.C.C. within 10 days when injection commences or terminates.
9. If an alternate 2 completion, cement in the production pipe from below any usable water to surface within 120 days of spud date.


RECEIVED

STATE CORPORATION COMMISSION

A Regular Section of **SET** 10 1985
1 Mile = 5,280 Ft.

CONSERVATION DIVISION

Wichita, Kansas

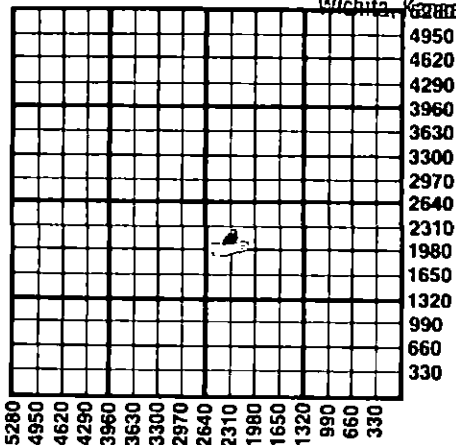

9-10-85

State Corporation Commission of Kansas
Conservation Division
200 Colorado Derby Building
Wichita, Kansas 67202
(316) 263-3238