


STATE OF KANSAS  
STATE CORPORATION COMMISSION

WELL PLUGGING RECORD

Give All Information Completely  
Make Required Affidavit  
Mail or Deliver Report to  
Conservation Division  
State Corporation Comm.  
245 North Water  
Wichita, KS 67202

Ness County, Sec. 6 Twp. 20 Rge. 24W  
Location as "NE/CNW $\frac{1}{4}$ SW $\frac{1}{4}$ " or footage from lines  
100' E of NE SW

Lease Owner Vincent Oil Corporation  
Lease Name Schlegel Well No. 1  
Office Address 230 O.W. Garvey Building, Wichita, 67202  
Character of Well (Completed as Oil, Gas or Dry Hole) Dry Hole

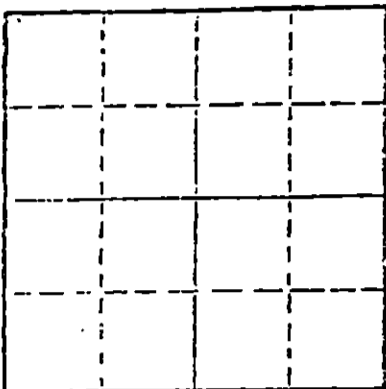

Locate well correctly on above  
Section Plot

Date Well completed 7/17/80 19  
Application for plugging filed 7/17/80 19  
Application for plugging approved 7/17/80 19  
Plugging commenced 7/17/80 19  
Plugging completed 7/17/80 19  
Reason for abandonment of well or producing formation

If a producing well is abandoned, date of last production 19

Was permission obtained from the Conservation Division or its agents before plugging was commenced? Yes

Name of Conservation Agent who supervised plugging of this well Marion Schmidt  
Producing formation Depth to top Bottom Total Depth of Well  
Show depth and thickness of all water, oil and gas formations. RTE 4420'

OIL, GAS OR WATER RECORDS

CASING RECORD

FORMATION	CONTENT	FROM	TO	SIZE	PUT IN	PULLED OUT
	Surface	0	602'	8-5/8"	yes	no

Describe in detail the manner in which the well was plugged, indicating where the mud fluid was placed and the method or methods used in introducing it into the hold. If cement or other plugs were used, state the character of same and depth placed, from feet to feet for each plug set.

1st plug @ 850' with 70 sacks  
2nd plug @ 240' with 25 sacks  
3rd plug @ 40' with 10 sacks  
5 sacks in rathole  
Job complete @ 2:30 p.m. 7/17/80

(If additional description is necessary, use BACK of this sheet)

Name of Plugging Contractor Slawson Drilling Company, Inc.

STATE OF Kansas COUNTY OF Sedgwick, ss.


James C. Remsberg, Slawson Drilling Company, Inc. (employee of owner) or (owner or operator of the above-described well, being first duly sworn on oath, says: That I have knowledge of the facts, statements, and matters herein contained and the log of the above-described well as filed and that the same are true and correct. So help me God.

(Signature) James C. Remsberg  
James C. Remsberg  
208 Douglas Building, Wichita 67202  
(Address)

SUBSCRIBED AND SWORN TO before me this 22 day of July, 19 80

Mary Lou Taylor  
Mary Lou Taylor  
Notary Public.

My commission expires January 17, 1981

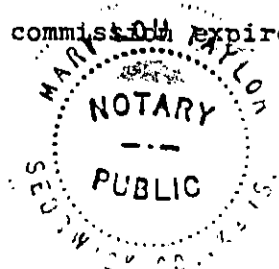

RECEIVED  
STATE CORPORATION COMMISSION

JUL 23 1980  
CONSERVATION DIVISION  
Wichita, Kansas

DRILLERS LOG

OPERATOR: Vincent Oil Corporation  
 230 O. W. Garvey Building  
 Wichita, Kansas 67202

WELL NAME: Schlegel #1  
 100' E of NE SW Sec.6-20S-24W  
 Ness County, Kansas

CONTRACTOR: Slawson Drilling Company, Inc.  
 200 Douglas Building  
 Wichita, Kansas 67202

COMMENCED: 7/8/80

COMPLETED: 7/17/80

RTD: 4420'

SURFACE CASING: 8-5/8" set at 602' with 400 sx cement

0' to 606' 12½" Surface Hole  
 606 to 1449' Shale & Shells  
 1449' to 2750' Shale  
 2750' to 2940' Shale & Lime  
 2940' to 3320' Lime & Shale  
 3320' to 3926' Lime  
 3926' to 4060' Shale & Lime  
 4060' to 4420' Lime  
 RTD 4420'

STATE OF KANSAS  
 COUNTY OF SEDGWICK

I, James C. Remsberg, of the Slawson Drilling Company, Inc.  
 hereby state the above is an accurate copy of the Schlegel #1 log  
 for Vincent Oil Corporation.

*James C. Remsberg*  
 James C. Remsberg

Subscribed and sworn to me  
 this 22 day of July, 1980

*Mary Lou Taylor*  
 Mary Lou Taylor, Notary

My commission expires January 17, 1981

