


STATE OF KANSAS
STATE CORPORATION COMMISSION
CONSERVATION DIVISION
P. O. BOX 17027
WICHITA, KANSAS 67217

WELL PLUGGING RECORD

Ness County, Sec. 2 Twp. 20S Rge. 24W (E) (W)
SW NE

NORTH

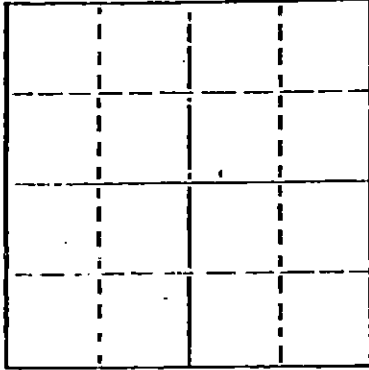

Locate well correctly on above Section Plat

Location as "NE/CNWESW" or footage from lines
Lease Owner PICKRELL DRILLING COMPANY
Lease Name HAIR-LUNDY "A" Well No. 2
Office Address 205 LITWIN BLDG., WICHITA, KS. 67202
Character of Well (completed as Oil, Gas or Dry Hole) Dry Hole
Date well completed 3-9-76 19
Application for plugging filed 3-9-76 19
Application for plugging approved 3-9-76 19
Plugging commenced 3-9-76 19
Plugging completed 3-9-76 19
Reason for abandonment of well or producing formation Dry Hole

If a producing well is abandoned, date of last production 19
Was permission obtained from the Conservation Division or its agents before plugging was commenced? Yes

Name of Conservation Agent who supervised plugging of this well Leo Massey
Producing formation Depth to top Bottom Total Depth of Well 4457
Show depth and thickness of all water, oil and gas formations.

OIL, GAS OR WATER RECORDS

CASING RECORD

FORMATION	CONTENT	FROM	TO	SIZE	PUT IN	PULLED OUT
				8 5/8	303	None

Describe in detail the manner in which the well was plugged, indicating where the mud fluid was placed and the method or methods used in introducing it into the hole. If cement or other plugs were used, state the character of same and depth placed, from feet to feet for each plug set.

550' w/70 SX
250' w/20sx
40' w/bridge 10sx Comp. 5PM 3-9-76

Name of Plugging Contractor PICKRELL DRILLING COMPANY
Address 205 Litwin Bldg., Wichita, Ks. 67202

STATE OF Kansas COUNTY OF Sedgwick
C. W. Sebitts

(employee of owner) or (owner or operator) of the above-described well, being first duly sworn on oath, says: That I have knowledge of the facts, statements and matters herein contained and the log of the above-described well as filed and that the same are true and correct. So help me God.

(Signature) C. W. Sebitts
205 Litwin Bldg., Wichita, Ks. 67202
(Address)

SUBSCRIBED AND SWORN TO before me this 23 day of March 19 76

My commission expires

Jo Ann Sarver
Notary Public.



ROTARY DRILLING LOG

15.135.21169.0000

COMPANY: PICKRELL DRILLING COMPANY
205 LITWIN BLDG.,
WICHITA, KANSAS 67202
LOCATION: HAIR-LUNDY "A" #2
SW NE 2-20S-24W
NESS COUNTY, KANSAS
CONTRACTOR: **PICKRELL DRILLING COMPANY**
Wichita, Kansas

Rotary Drilling Commenced 2-28-76
Rotary Drilling Completed 3-09-76

CASING RECORD: 8 5/8 surface casing set at 303' KB w/225 sx. Comp. 2-28-76

LOG

(Figures indicate bottom of formation — measurements from top of rotary bushing.)

Top Soil & Clay	35
Shale	190
Sand	275
Shale & Sand Streaks	965
Shale	978
Shale	1060
Sand	1270
Shale	1760
Shale	2145
Shale & Lime	2430
Shale & Lime	2570
Shale & Lime	2745
Shale & Lime	2900
Shale & Lime	3075
Lime & Shale	3260
Lime & Shale	3405
Shale & Lime	3595
Shale & Lime	3800
Lime & Shale	3881
Shale & Lime	3962
Lime	4045
Lime	4130
Lime	4200
Lime	4250
Lime	4292
Lime	4330
Lime	4334
Shale & Lime	4370
Lime & Shale	4432
Dolomite	4439
Dolomite	4447
Dolomite	4457

APR 05 1976
Seal
Wichita, Kansas

The undersigned, C. W. Sebitts, Attorney-in-Fact for PICKRELL DRILLING COMPANY, hereby certifies in behalf of said Company, that the above is a true and correct log of the formation encountered in drilling the above well as reflected by the Daily Drilling Reports.

PICKRELL DRILLING COMPANY
By [Signature]
C. W. Sebitts Attorney-in-Fact

STATE OF KANSAS }
COUNTY OF SEDGWICK } ss.:

On this 23 day of March, 19 76, before me the undersigned, a Notary Public, in and for the County and State aforesaid, personally appeared C. W. Sebitts, to me known to be the identical person who subscribed the name of PICKRELL DRILLING COMPANY to the foregoing instrument as its Attorney-in-Fact and acknowledged to me that he executed the same as his free and voluntary act and deed, and as the free and voluntary act and deed of such company, for the uses and purposes therein set forth.

Given under my hand and seal of office the day and year last above written.

My commission expires:

[Signature]
Notary Public
Jo Ann Sarver

