


STATE OF KANSAS  
STATE CORPORATION COMMISSION

WELL PLUGGING RECORD

Give All Information Completely  
Make Required Affidavit  
Mail or Deliver Report to:  
Conservation Division  
State Corporation Commission  
211 No. Broadway  
Wichita, Kansas

Ness County, Sec. 36 Twp. 20S Rge. 26W (E) (W)

Location as "NE/CNW/SW" or footage from lines SE SW  
Lease Owner Thunderbird Drilling, Inc.  
Lease Name Putnam "B" Well No. 4  
Office Address P.O. Box 18407- Wichita, Kansas  
Character of Well (completed as Oil, Gas or Dry Hole) Dry Hole  
Date well completed 3/15/77 19  
Application for plugging filed 3/15/77 19  
Application for plugging approved 3/15/77 19  
Plugging commenced 3/15/77 19  
Plugging completed 3/15/77 19  
Reason for abandonment of well or producing formation Dry Hole

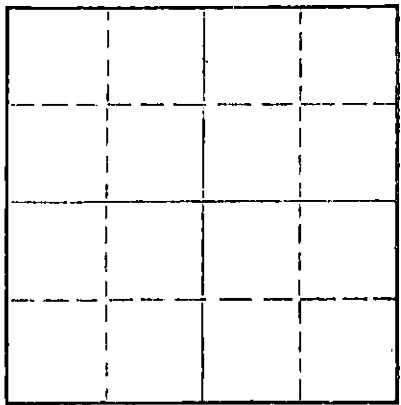

Locate well correctly on above Section Plat

If a producing well is abandoned, date of last production 19  
Was permission obtained from the Conservation Division or its agents before plugging was commenced? Yes

Name of Conservation Agent who supervised plugging of this well Leo Massey  
Producing formation \_\_\_\_\_ Depth to top \_\_\_\_\_ Bottom \_\_\_\_\_ Total Depth of Well \_\_\_\_\_ Feet  
Show depth and thickness of all water, oil and gas formations.

OIL, GAS OR WATER RECORDS

CASING RECORD

FORMATION	CONTENT	FROM	TO	SIZE	PUR IN	PULLED OUT
		0	313	8-5/8"	313	0

Describe in detail the manner in which the well was plugged, indicating where the mud fluid was placed and the method or methods used in introducing it into the hole. If cement or other plugs were used, state the character of same and depth placed, from \_\_\_\_\_ feet to \_\_\_\_\_ feet for each plug set.

1st Plug @ 750' w/45 sx  
2nd Plug @ 325' w/20 sx  
3rd Plug @ 40' w/10 sx

(If additional description is necessary, use BACK of this sheet)  
Name of Plugging Contractor Thunderbird Drilling, Inc.  
Address P.O. Box 18407- Wichita, Kansas 67218

STATE OF KANSAS, COUNTY OF SEDGWICK, ss. Burke Krueger

(employee of owner) or (owner or operator) of the above-described well, being first duly sworn on oath, says: That I have knowledge of the facts, statements, and matters herein contained and the log of the above-described well as filed and that the same are true and correct. So help me God.

(Signature) *Burke Krueger*

(Address)

SUBSCRIBED AND SWORN TO before me this 23rd day of March, 1977

*Gloria DeJesus*

Commission expires 3-25-80

Notary Public.



JUN 17 1977  
6-17-77  
Wichita, Kansas

DRILLERS LOG

Company Thunderbird Drilling, Inc. Contractor Thunderbird Drilling, Inc.

Elevation 2439' K.B.

Farm Putnam "B"

Well No. 4 Casing 8-5/8" @ .313' w/225 sx,

Location SE SW  
Sec. 36-20S-26W

Production

County Ness

<u>From</u>	<u>To</u>	<u>Description</u>
0	313	Surface Hole
313	835	Shale & Sand
835	1142	Shale & Blaine Anhy.
1142	1375	Sand
1375	1639	Shale & Shells
1639	1672	Anhydrite
1672	2245	Shale & Shells
2245	2275	Shale & Lime
2275	2475	Lime & Shale
2475	2765	Shale & Lime
2765	2910	Lime & Shale
2910	3075	Shale & Lime
3075	3380	Lime & Shale
3380	3725	Shale & Lime
3725	3801	Lime & Shale
3801	4015	Shale & Lime
4015	4315	Lime & Shale
4315	4340	Lime
4340	4380	Lime & Shale
4380	4422	Lime
4422	4429	Lime & Shale
4429	4450	Lime
4450	T.D.	

STATE OF KANSAS )  
 ) ss.  
COUNTY OF SEDGWICK )

I, Burke Krueger, of Thunderbird Drilling, Inc. upon oath states that the above and foregoing is a true and correct copy from the Daily Drilling Report from your Putnam "B" #4.

*Burke Krueger*

Subscribed and sworn to before me this 23rd day of March, 19 77.

*Gloria DeJesus*

Gloria DeJesus Notary Public



My commission expires: 3-25-80

RECEIVED  
STATE CORPORATION COMMISSION  
JUN 17 1977  
CONSERVATION DIVISION  
Wichita, Kansas