


STATE OF KANSAS
STATE CORPORATION COMMISSION

Give All Information Completely
Make Required Affidavit
Mail or Deliver Report to:
Conservation Division
State Corporation Commission
212 No. Market
Wichita, Kansas

WELL PLUGGING RECORD

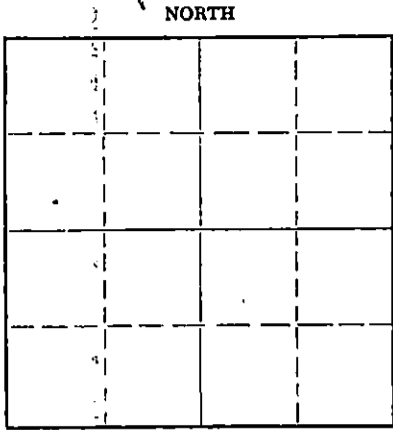

Locate well correctly on above
Section Plat

Ness County. Sec. 26 Twp. 20S Rge. 24W (E) (W)
Location as "NE/CNW&SW&" or footage from lines. C NE NE
Lease Owner Texaco, Inc.
Lease Name Raymond Pember Well No. 1
Office Address 614 Bitting Bldg., Wichita, Kansas
Character of Well (completed as Oil, Gas or Dry Hole) Dry Hole
Date well completed 6-8-67 19
Application for plugging filed 6-8-67 19
Application for plugging approved 6-8-67 19
Plugging commenced 6-8-67 19
Plugging completed 6-8-67 19
Reason for abandonment of well or producing formation Dry Hole

If a producing well is abandoned, date of last production 19
Was permission obtained from the Conservation Division or its agents before plugging was commenced? yes

Name of Conservation Agent who supervised plugging of this well Leo Massey
Producing formation _____ Depth to top _____ Bottom _____ Total Depth of Well 4426 Feet
Show depth and thickness of all water, oil and gas formations.

OIL, GAS OR WATER RECORDS

CASING RECORD

FORMATION	CONTENT	FROM	TO	SIZE	PUT IN	PULLED OUT
				8 5/8"	289'	none

Describe in detail the manner in which the well was plugged, indicating where the mud fluid was placed and the method or methods used in introducing it into the hole. If cement or other plugs were used, state the character of same and depth placed, from _____ feet to _____ feet for each plug set.

Set Plug @ 540' with 30 sks. Common
Set Plug @ 280' with 20 sks. common
Bridged plug @ 40' w/10 sks. Common, 1/2 sk. hulls

RECEIVED
STATE CORPORATION COMMISSION

JUN 18 1967

CONSERVATION DIVISION
WICHITA, KANSAS

(If additional description is necessary, use BACK of this sheet)

Name of Plugging Contractor Leben Drilling, Inc.
Address Box 486, Great Bend, Kansas 67530

STATE OF KANSAS, COUNTY OF BARTON, ss.

Leslie Kite (employee of owner) or (owner or operator) of the above-described well, being first duly sworn on oath, says: That I have knowledge of the facts, statements, and matters herein contained and the log of the above-described well as filed and that the same are true and correct. So help me God.

(Signature)

Leslie Kite

Box 486, Great Bend, Kansas 67530

(Address)

SUBSCRIBED AND SWORN to before me this 12th day of June, 19 67

My commission expires April 1, 1971

Clara M. Nichols
Notary Public.

DRILLER'S LOG

COMPANY: Texaco, Inc.
 CONTRACTOR: LEBEN DRILLING, INC.
 FARM: RAYMOND PEMBER #1
 LOCATION: C NE NE SEC. 26-20S-24W
 NESS COUNTY, KANSAS
 COMMENCED: 5-29-67
 COMPLETED: 6-8-67

0	70	Clay, Sand
70	740	Shale
740	887	Sand, Redbed
887	906	Anhydrite
906	1542	Sand
1542	1565	Anhydrite
1565	2000	Redbed, Shale
2000	2245	Shale, Lime Streaks
2245	2468	Shale
2468	3642	Lime, Shale
3642	3735	Shale, Lime
3735	3940	Lime, Shale
3940	4426	Lime
	<u>4426</u>	<u>RTD - D. & A.</u>

RECEIVED
STATE CORPORATION COMMISSION

JUN 13 1967

CONSERVATION DIVISION
Wichita, Kansas

8 5/8" spiral weld surface casing set @ 289' cemented with 175
sks. Common, 2% cc

I, Leslie Kite, do hereby certify that the above and foregoing is
a true and correct copy of the log of the Raymond Pember #1 Well,
located C NE NE, Section 26, Township 20 South, Range 24 West Ness
County, Kansas, as reflected by the records of Leben Drilling, Inc.

Leslie Kite

Leslie Kite

STATE OF KANSAS)
) SS
COUNTY OF BARTON)

Subscribed and sworn to and before me, a Notary Public, in
and for Barton County, Kansas, this 12th day of June, 1967.

Ulanda Nichols

Ulanda Nichols

My Commission Expires:
April 1, 1971