


Give All Information Completely
Make Required Affidavit
Mail or Deliver Report to:
Conservation Division
State Corporation Commission
211 No. Broadway
Wichita, Kansas

WELL PLUGGING RECORD

Ness County, Sec. 35 Twp. 20 Rge. 26 W (E) (W)

Location as "NE/CNW/SW" or footage from lines C SW NE
Lease Owner Mull Drilling Co. Inc.
Lease Name Goodman Well No. 2
Office Address 1625 Plaza Bldg. Wichita, Kansas
Character of Well (completed as Oil, Gas or Dry Hole) Dry hole.
Date well completed 6-15-63 19
Application for plugging filed 6-15-63 19
Application for plugging approved 6-15-63 19
Plugging commenced 12:00 P.M. 6-15-63 19
Plugging completed 1:00 P. M. 6-15-63 19
Reason for abandonment of well or producing formation Non producing

NORTH

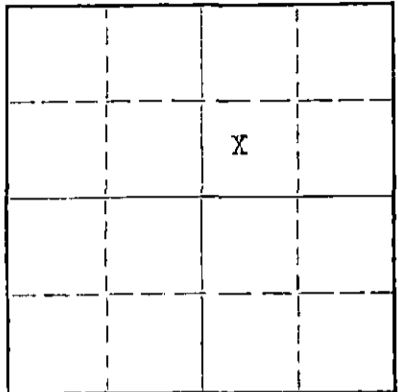

Locate well correctly on above Section Plat

If a producing well is abandoned, date of last production 19
Was permission obtained from the Conservation Division or its agents before plugging was commenced? Yes

Name of Conservation Agent who supervised plugging of this well Mr. Petty, Hays, Kansas
Producing formation _____ Depth to top _____ Bottom _____ Total Depth of Well 4442' Feet
Show depth and thickness of all water, oil and gas formations.

OIL, GAS OR WATER RECORDS

CASING RECORD

FORMATION	CONTENT	FROM	TO	SIZE	PUT IN	PULLED OUT

Describe in detail the manner in which the well was plugged, indicating where the mud fluid was placed and the method or methods used in introducing it into the hole. If cement or other plugs were used, state the character of same and depth placed, from _____ feet to _____ feet for each plug set.

Plugged through drill pipe with pump truck, with a plug and 20 sacks cement at 550'
a plug and 20 sacks cement at 240', and a plug and 1/4 sack hulls and 10 sacks at 140'.

RECEIVED
STATE CORPORATION COMMISSION

JUN 20 1963

CONSERVATION DIVISION
Wichita, Kansas

(If additional description is necessary, use BACK of this sheet)
Name of Plugging Contractor Globe cementing co.
Address Great Bend, Kansas

STATE OF KANSAS, COUNTY OF SEDGWICK, ss.
Joseph O. Butts (employee of owner) or (owner or operator) of the above-described well, being first duly sworn on oath, says: That I have knowledge of the facts, statements, and matters herein contained and the log of the above-described well as filed and that the same are true and correct. So help me God.

(Signature) Joseph O. Butts
Wichita, Kansas (Address)

SUBSCRIBED AND SWORN TO before me this 18th day of June, 1963

B. Stitt H. Satter
Notary Public.

My commission expires October 16, 1965

R O T A R Y D R I L L E R S ' L O G

COMPANY: Mull Drilling Co., Inc. ROTARY DRILLING COMMENCED:
 Wichita, Kansas
 CONTRACTOR: Mull Drilling Co., Inc. ROTARY DRILLING COMPLETED:
 Wichita, Kansas
 CASING RECORD: Set 354' of 8 5/8" LOCATION: #2 Goodman
 Surf. csg. w/200 sx. C SW NE 35-20S-26W
 Ness County, Kansas

(Figures indicate bottom of formation - measurements from top of Rotary Bushing.)

20'	Surface Soil
60'	Clay & Sand
355'	Blue Shale
415'	shale & Clay
1030'	Shale & sand
1680'	Shale, Etc.
1720'	Anhydrite
2145'	Shale
2927'	Lime w/shale
3095'	Sandy Lime w/shale
3340'	Shale & Lime
3445'	Sandy Lime & Shale
3567'	Shale w/Lime
3750'	Chalky Lime w/shale
4410'	Lime w/shale
4415'	Mississippi
4432'	Conglomerate
4442'	Mississippi and Total Depth

RECEIVED
 STATE CORPORATION COMMISSION

JUN 20 1963

CONSERVATION DIVISION
 Wichita, Kansas

I hereby certify that this is a true and correct copy of the above log to the best of my knowledge.

MULL DRILLING COMPANY, INC.

Joseph B. Brunardt, Jr.
 JOSEPH B. BRUNARDT, JR.

STATE OF KANSAS)
) SS
 COUNTY OF SEDGWICK)

Subscribed and sworn before me this 19th day of June, 1963.

Lola L. Foster

Lola L. Foster, Notary Public



My commission expires April 17, 1966.