


STATE OF KANSAS  
STATE CORPORATION COMMISSION

Form CP-4

WELL PLUGGING RECORD

Give All Information Completely  
Make Required Affidavit  
Mail or Deliver Report to:  
Conservation Division  
State Corporation Commission  
P. O. Box 17027  
Wichita, Kansas 67217

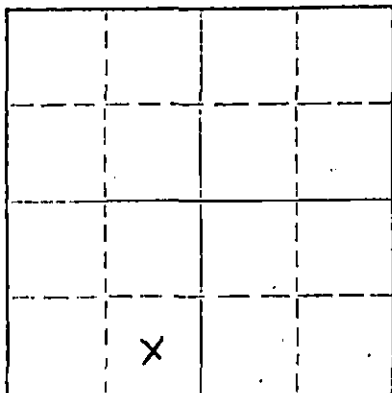

Locate well correctly on above Section Plat

Ness County. Sec. 25 Twp. 20 Rge. 21 (E) W (W)  
Location as "NE/CNW/SW" or footage from lines C SE SW  
Lease Owner Pickrell Drlg. Co. ; Wichita, Kansas 67202  
Lease Name Wells \*D\* Well No. # 1  
Office Address 205 Fourth National Bank Building  
Character of Well (completed as Oil, Gas or Dry Hole) Oil  
Date well completed May 10 19 65  
Application for plugging filed January 13 19 72  
Application for plugging approved January 14 19 72  
Plugging commenced February 21 19 72  
Plugging completed March 6 19 72  
Reason for abandonment of well or producing formation Depleted

If a producing well is abandoned, date of last production November 1 19 71  
Was permission obtained from the Conservation Division or its agents before plugging was commenced? Yes

Name of Conservation Agent who supervised plugging of this well Leo Massey  
Producing formation Mississippian Depth to top 4380' Bottom 4465' Total Depth of Well 4465 Feet  
Show depth and thickness of all water, oil and gas formations.

OIL, GAS OR WATER RECORDS

CASING RECORD

FORMATION	CONTENT	FROM	TO	SIZE	PUT IN	PULLED OUT
				8 5/8"	258	None
				4 1/2"	4467	495

Describe in detail the manner in which the well was plugged, indicating where the mud fluid was placed and the method or methods used in introducing it into the hole. If cement or other plugs were used, state the character of same and depth placed, from \_\_\_\_\_ feet to \_\_\_\_\_ feet for each plug set.

February 21, 1972 Plugged off bottom. Dumped sand to 4300'. Mixed and dumped 4 sx of cement.  
March 6, 1972 Plugged off top. Globe Oil Well Cementing Co. mixed and pumped down 8 5/8" surface casing, 2 sx of hulls, 10 sx of gel, released plug and 100 sx of cement.

RECEIVED  
STATE CORPORATION COMMISSION  
MAR 13 1972  
CONSERVATION DIVISION  
Wichita, Kansas


(If additional description is necessary, use BACK of this sheet)  
Name of Plugging Contractor RUSS CASING PULLING, INC.  
Address P. O. Box 1082 ; Great Bend, Kansas 67530

STATE OF Kansas, COUNTY OF Sedgwick, ss.  
Dale M. Robinson (employee of owner) or (owner or operator) of the above-described

well, being first duly sworn on oath, says: That I have knowledge of the facts, statements, and matters herein contained and the log of the above-described well as filed and that the same are true and correct. So help me God.

(Signature) Dale M. Robinson  
705 Fourth National Bank Bldg., Wichita, Kansas  
(Address)

9th day of March, 19 72

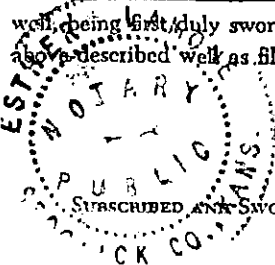

Esther Lamone  
Notary Public.

My commission expires January 19, 1973

**ROTARY DRILLING LOG**

*9*

COMPANY: **PICKRELL DRILLING COMPANY**  
 705 4th National Bank Building  
 Wichita, Kansas

Rotary Drilling Commenced 4-17-65

Rotary Drilling Completed 4-29-65

LOCATION: **WELLS "D" No. 1, 150' SE C SE SW Section 25-20-21W, Ness County, Kansas.**

CONTRACTOR: **PICKRELL DRILLING COMPANY**  
 Wichita, Kansas

CASING RECORD: 258' (12 jts) 8 5/8" surface casing set with 160 sacks cement.  
 Circulated. (115 jts) 4 1/2" casing set at 4464' with 100 sacks  
 cement. Completed 7:30 P.M. April 29, 1965.

**LOG**

(Figures indicate bottom of formation — measurements from top of rotary bushing.)

40	Top Soil & Post Rock	<u>C. F. S.</u>
190	Shale	4315
200	Sand Streaks	4330
315	Blue Shale	4385
760	Shale, Shells & Red Bed	4395
770	Blaine	4405
855	Red Beds, Shale & Shells	4415
1050	Sand	4465
1415	Shale & Shells	
1445	Anhydrite	<u>Slope Tests</u>
1930	Shale & Shells	1500
2405	Lime & Shale	2500
2720	Lime	3500
2945	Lime & Shale	4000
3060	Shale	
3315	Lime & Shale	<u>S. L. M.</u>
3475	Shale	3599
3685	Lime & Shale	4082
3790	Shale	4350
4225	Lime	
4300	Lime & Shale	
4330	Ft. Scott	
4379	Lime & Shale	
4465	Mississippian - RTD	

RECEIVED  
 STATE CORPORATION COMMISSION  
 JAN 14 1972  
 CONSERVATION DIVISION  
 Wichita, Kansas

The undersigned, C. W. SEBITS, Attorney-in-Fact for PICKRELL DRILLING COMPANY, hereby certifies in behalf of said Company, that the above is a true and correct log of the formation encountered in drilling the above well as reflected by the Daily Drilling Reports.

PICKRELL DRILLING COMPANY

By C. W. Sebits, Attorney-in-Fact

STATE OF KANSAS }  
 COUNTY OF SEDGWICK } ss.:

On this 24th day of May, 19 65, before me the undersigned, a Notary Public, in and for the County and State aforesaid, personally appeared C. W. SEBITS, to me known to be the identical person who subscribed the name of PICKRELL DRILLING COMPANY to the foregoing instrument as its Attorney-in-Fact and acknowledged to me that he executed the same as his free and voluntary act and deed, and as the free and voluntary act and deed of such company, for the uses and purposes therein set forth.

Given under my hand and seal of office the day and year last above written.

My commission expires: June 21, 1966

Maxine Blackman  
 Maxine Blackman, Notary Public