

STATE OF KANSAS
STATE CORPORATION COMMISSION

WELL PLUGGING RECORD

Give All Information Completely
Make Required Affidavit
Mail or Deliver Report to:
Conservation Division
State Corporation Commission
211 No. Broadway
Wichita, Kansas

Ness County. Sec. 25 Twp. 20S Rge. 21W (E) (W)

Location as "NE/CNW%SW%" or footage from lines 150' S. of SE NW

Lease Owner Marmik Oil Company

Lease Name William C. Wells Well No. 2

Office Address 110 West Elm St., Eldorado, Arkansas 71730

Character of Well (completed as Oil, Gas or Dry Hole) Dry hole

Date well completed June 2 19 66

Application for plugging filed June 2 19 66

Application for plugging approved June 2 19 66


Plugging commenced June 2 19 66

Plugging completed June 2 19 66

Reason for abandonment of well or producing formation Dry hole

If a producing well is abandoned, date of last production 19

Was permission obtained from the Conservation Division or its agents before plugging was commenced? yes

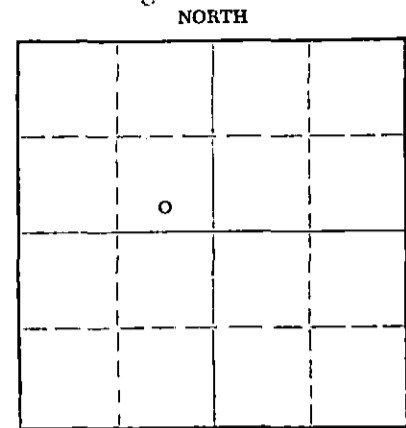

Locate well correctly on above Section Plat

Name of Conservation Agent who supervised plugging of this well Eldon Petty, Hays, Kansas

Producing formation _____ Depth to top _____ Bottom _____ Total Depth of Well 4420 Feet

Show depth and thickness of all water, oil and gas formations.

OIL, GAS OR WATER RECORDS

CASING RECORD

FORMATION	CONTENT	FROM	TO	SIZE	PUT IN	PULLED OUT
		0	252	8 5/8"	252'	None

Describe in detail the manner in which the well was plugged, indicating where the mud fluid was placed and the method or methods used in introducing it into the hole. If cement or other plugs were used, state the character of same and depth placed, from _____ feet to _____ feet for each plug set.

Set Plug: 550'/25 sacks cement/1/4 sack hulls
240'/20 sacks cement/1/4 sack hulls
40'/10 sacks cement/1/4 sack hulls

RECEIVED
STATE CORPORATION COMMISSION

JUN - 9 1966

CONSERVATION DIVISION
Wichita, Kansas

(If additional description is necessary, use BACK of this sheet)

Name of Plugging Contractor Hellar Drilling Company, Inc.
Address 1014 Union Center, Wichita, Kansas 67202

STATE OF Kansas, COUNTY OF Sedgwick, ss.

D. L. Hellar, President of Hellar Drilling Company (employee of owner) or (owner or operator) of the above-described well, being first duly sworn on oath, says: That I have knowledge of the facts, statements, and matters herein contained and the log of the above-described well as filed and that the same are true and correct. So help me God.

(Signature) D. L. Hellar D. L. Hellar, President
1014 Union Center, Wichita, Kansas 67202
(Address)

SUBSCRIBED AND SWORN TO before me this 7th day of June, 19 66

Catherine Darcey
Catherine Darcey -- Notary Public.

My commission expires March 25, 1968

DRILLER'S LOG

COMPANY: Marmik Oil Company, 110 West Elm St., Eldorado, Ark.
 CONTRACTOR: Hellar Drilling Company, Inc., Wichita, Kansas
 LEASE: #2 William C. Wells
 LOCATION: 150' S. of SE NW Sec. 25-20S-21W, Ness County, Kansas
 COMMENCED: May 24, 1966
 COMPLETED: June 2, 1966
 CASING: Set 8 5/8" surface casing @ 252'/185 sacks cement

0-150	Surface Clay, shale
150-253	Shale & sand
253-1419	Red Bed & shale
1419-1446	Anhydrite
1446-1503	Shale & shells
1503-1855	Red Bed, shale & shells, & salt section
1855-2192	Shale & salt section
2192-2355	Salt Section
2355-2733	Ft. Riley cherty lime
2733-3589	Shale & lime
3589-3880	Lime & shale
3880-4027	Lime
4027-4094	L. K.C.
4094-4169	Lime
4169-4230	Lime & shale
4230-4308	Lime & shale streaks
4308-4375	Lime & shale
4375-4395	Cong.
4395-4420	Miss. chert
4420	Rotary Total Depth

RECEIVED
 STATE CORPORATION COMMISSION
 JUN - 8 1966
 CONSERVATION DIVISION
 Wichita, Kansas

STATE OF KANSAS)
) SS
 COUNTY OF SEDGWICK)

I, D. L. Hellar, do hereby certify that the above and foregoing is a true and correct copy of the log of the #2 William C. Wells, located 150' S. of SE NW 25-20S-21W, Ness County, Kansas, as reflected by the files of the Hellar Drilling Company, Inc.

HELLAR DRILLING COMPANY, INC.

By D. L. Hellar
 President - D. L. Hellar

Subscribed and sworn to before me, a Notary Public, in and for Sedgwick County, Kansas, this 7th day of June, 1966.

My Commission Expires: March 25, 1968.

Catherine Darcey
 Notary Public - Catherine Darcey