


STATE OF KANSAS  
STATE CORPORATION COMMISSION

WELL PLUGGING RECORD

Give All Information Completely  
Make Required Affidavit.  
Mail or Deliver Report to  
Conservation Division  
State Corporation Comm.  
245 North Water  
Wichita, KS 67202

Ness County, Sec. 30 Twp. 17S Rge. 21W ~~22E~~  
Location as "NE/CNW 1/4 SW 1/4" or footage from lines \_\_\_\_\_  
C SE NE

Lease Owner Hummon Oil Company  
Lease Name Brenner Well No. 1  
Office Address 1725 Vickers-KSB&T Bldg., Wichita, Ks.  
Character of Well (Completed as Oil, Gas or Dry Hole) \_\_\_\_\_

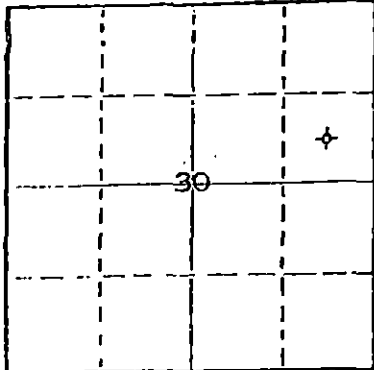

Locate well correctly on above  
Section Plat

Dry Hole  
Date Well completed July 23, 1978  
Application for plugging filed July 23, 1978  
Application for plugging approved July 23, 1978  
Plugging commenced July 23, 1978  
Plugging completed July 23, 1978  
Reason for abandonment of well or producing formation \_\_\_\_\_

Dry Hole  
If a producing well is abandoned, date of last production \_\_\_\_\_ 19\_\_\_\_

Was permission obtained from the Conservation Division or its agents before plugging was commenced? Yes

Name of Conservation Agent who supervised plugging of this well \_\_\_\_\_  
Producing formation \_\_\_\_\_ Depth to top \_\_\_\_\_ Bottom \_\_\_\_\_ Total Depth of Well 4370'  
Show depth and thickness of all water, oil and gas formations.

OIL, GAS OR WATER RECORDS

CASING RECORD

FORMATION	CONTENT	FROM	TO	SIZE	PUT IN	PULLED OUT
		0'	387'	8-5/8"	380.85'	None

Describe in detail the manner in which the well was plugged, indicating where the mud fluid was placed and the method or methods used in introducing it into the hold. If cement or other plugs were used, state the character of same and depth placed, from \_\_\_\_\_ feet to \_\_\_\_\_ feet for each plug set.

RECEIVED  
STATE CORPORATION COMMISSION

Plugged with 70 sacks cement at 550',  
20 sacks cement at 300', plug & 1/2 sack  
hulls & 10 sacks cement at 40', 3 sacks  
cement in rat hole.

JUL 28 1978  
CONSERVATION DIVISION  
Wichita, Kansas

(If additional description is necessary, use BACK of this sheet)

Name of Plugging Contractor Allied Cementing Co.

STATE OF KANSAS COUNTY OF SEDGWICK, ss.  
John D. Knightley Agent (employee of owner) or (owner or operator)  
of the above-described well, being first duly sworn on oath, says: That I have knowledge of the facts, statements, and matters herein contained and the log of the above-described well as filed and that the same are true and correct. So help me God.

(Signature) [Signature]  
221 S. Broadway, Wichita, Kansas  
(Address)

SUBSCRIBED AND SWORN TO before me this 27th day of July, 1978

[Signature]  
Notary Public.

My commission expires March 12, 1979

Hummon Oil Company - Brenner #1  
C SE NE Sec. 30-17S-21W  
Ness County, Kansas

Contractor: D. R. Lauck Oil Company, Inc.  
221 S. Broadway, Suite 400  
Wichita, Kansas 67202

Commenced: July 10, 1978  
Completed: July 23, 1978

Drillers Log

Shale	568
Shale & Red Bed	1516
Anhydrite	1544
Red Bed	1630
Shale & Shells	2810
Shale & Lime	3145
Lime	3345
Lime & Shale	3700
Lime	4370 RTD

RECEIVED  
STATE CORPORATION COMMISSION  
JUL 28 1978  
CONSERVATION DIVISION  
Wichita, Kansas