


WELL PLUGGING RECORD

Give All Information Completely
Make Required Affidavit
Mail or Deliver Report to:
Conservation Division
State Corporation Commission
212 No. Market
Wichita, Kansas

NORTH

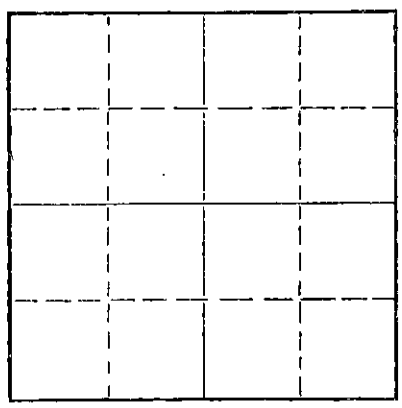

Locate well correctly on above
Section Plat

Ness County, Sec. 24 Twp. 20-S Rge. 21 (SE) (W)
Location as "NE/CNW/SW" or footage from lines CSESW
Lease Owner Oilfield Supply & Trading, Inc.
Lease Name Rowland Well No. 1
Office Address 430 Greenwood, Wichita, Kansas 67211
Character of Well (completed as Oil, Gas or Dry Hole) Dry Hole (Wash Down)
Date well completed 4-15 19 69
Application for plugging filed May 14 19 70
Application for plugging approved May 26 19 70
Plugging commenced May 27 19 70
Plugging completed June 2 19 70
Reason for abandonment of well or producing formation Dry Hole

If a producing well is abandoned, date of last production None 19
Was permission obtained from the Conservation Division or its agents before plugging was commenced? Yes

Name of Conservation Agent who supervised plugging of this well Leo Massey
Producing formation Mississippi Depth to top 4347 Bottom 4444 Total Depth of Well 4444 Feet
Show depth and thickness of all water, oil and gas formations.

OIL, GAS OR WATER RECORDS

CASING RECORD

FORMATION	CONTENT	FROM	TO	SIZE	PUT IN	PULLED OUT
<u>Mississippi</u>	<u>Pipe was collapsed formation was never opened.</u>			<u>4-1/2"</u>	<u>4444'</u>	<u>2080'</u>

Describe in detail the manner in which the well was plugged, indicating where the mud fluid was placed and the method or methods used in introducing it into the hole. If cement or other plugs were used, state the character of same and depth placed, from feet to feet for each plug set.

Clean out cellar - dig deadman holes - rig up - push plug to 4125. Sand to 4100 - work pipe 7".
Dump 4 sax cement - sheet 4-1/2" pipe @ 3210 - Globe Cementing Co. spot 40 bbls oil.
Work pipe 20" - pulled pipe into @ 80 ft. - run steel nipple - work pipe 20".
Work pipe 20" - shoot @ 2472 - 2240 - 2080 work pipe loose - pull 41 joints pipe.
Globe Cementing Co. pumped 15 sax gel & 2 sax hulls @ 750 ft. - 70 sax cement @ 500 ft. - 20 sax @ 210 ft. - bridge @ 30 ft. - pump 10 sax cement to surface - tear down.

RECEIVED
STATE CORPORATION COMMISSION

(If additional description is necessary, use BACK of this sheet)
Name of Plugging Contractor Ralph Comstock JUN 23 1970
Address 320 N. Park, Stafford, Kansas 67578 CONSERVATION DIVISION
Wichita, Kansas

STATE OF Kansas, COUNTY OF Sedgwick, ss.
W. R. Justice (employee of owner) or (owner or operator) of the above-described well, being first duly sworn on oath, says: That I have knowledge of the facts, statements, and matters herein contained and the log of the above-described well as filed and that the same are true and correct. So help me God.

(Signature) W. R. Justice
430 Greenwood, Wichita, Kansas 67211 (Address)
SUBSCRIBED AND SWORN TO before me this 22nd day of June, 19 70
Ethel Spicer
Ethel Spicer
NOTARY PUBLIC
STATE OF KANSAS

My commission expires May 14, 1972