


STATE OF KANSAS
STATE CORPORATION COMMISSION

WELL PLUGGING RECORD

Give All Information Completely
Make Required Affidavit
Mail or Deliver Report to:
Conservation Division
State Corporation Commission
212 No. Market
Wichita, Kansas

Ness County, Sec. 24 Twp. 20S Rge. 21W (W)

Location as "NE/CNW/SW" or footage from lines: C NW SW
Lease Owner D. R. Lauck Oil Company, Inc.
Lease Name Rowland Well No. 2
Office Address 301 S. Broadway, Wichita, Kansas
Character of Well (completed as Oil, Gas or Dry Hole) Dry Hole
Date well completed May 31, 1968
Application for plugging filed May 31, 1968
Application for plugging approved May 31, 1968
Plugging commenced May 31, 1968
Plugging completed May 31, 1968
Reason for abandonment of well or producing formation Dry Hole

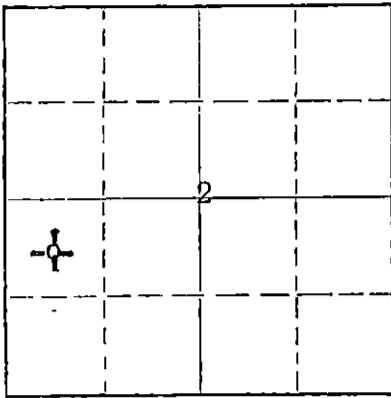

Locate well correctly on above
Section Plat

If a producing well is abandoned, date of last production 19
Was permission obtained from the Conservation Division or its agents before plugging was commenced? Yes

Name of Conservation Agent who supervised plugging of this well Leo Massey
Producing formation _____ Depth to top _____ Bottom _____ Total Depth of Well 4440 Feet
Show depth and thickness of all water, oil and gas formations.

OIL, GAS OR WATER RECORDS

CASING RECORD

FORMATION	CONTENT	FROM	TO	SIZE	PUT IN	PULLED OUT
		0'	314'	8-5/8"	314'	None

Describe in detail the manner in which the well was plugged, indicating where the mud fluid was placed and the method or methods used in introducing it into the hole. If cement or other plugs were used, state the character of same and depth placed, from _____ feet to _____ feet for each plug set.

4440'-600' Mud
600'-596' Plug
596'-556' Cement, 70 sacks.
556'-300' Mud
300'-296' Plug
296'-256' Cement, 20 sacks.
256'-40' Mud
40'-36' Plug
36'-6' Cement, 10 sacks. (Bottom of cellar)

RECEIVED
STATE CORPORATION COMMISSION
JUN 7 1968
CONSERVATION DIVISION
Wichita, Kansas

(If additional description is necessary, use BACK of this sheet)

Name of Plugging Contractor Halliburton Oil Well Cementing Co.
Address Great Bend, Kansas

STATE OF KANSAS, COUNTY OF SEDGWICK, ss.

John H. Knightley (employee of owner) or (owner or operator) of the above-described well, being first duly sworn on oath, says: That I have knowledge of the facts, statements, and matters herein contained and the log of the above-described well as filed and that the same are true and correct. So help me God.

(Signature) John H. Knightley
301 S. Broadway, Wichita, Kansas
(Address)

SUBSCRIBED AND SWORN TO before me this 5th day of June, 1968

Stella J. Lippe
Notary Public.

My commission expires March 12, 1971

D. R. Lauck Oil Company, Inc.

Rowland #2

C NW SW Sec. 24-20S-21W
Ness County, Kansas

Commenced: May 23, 1968

Completed: May 31, 1968

Casing Record: 314' 8-5/8" Cemented with 175 sacks Cement,
4 sacks Calcium Chloride.

Elevation: GL 2228; DF 2230; KB 2232.

Drillers Log

Tops

Surface Clay	30
Shale	135
Shale & Red Bed	314
Shale & Sand Streaks	595
Red Bed	762
Blaine	767
Red Bed & Sand Streaks	855
Sand	1060
Red Bed	1429
Anhydrite	1457
Shale & Shells	2145
Shale & Lime	2345
Lime & Shale	2500
Lime	2915
Shale & Lime	3115
Lime & Shale	3805
Lime	3915
Lime & Chert	3956
Lime & Shale	3980
Lime	4225
Lime & Shale	4406
Chert & Lime	4440 RTD

	Sample
Anhydrite	1429+803
Heebner	3751-1519
Lansing	3803-1571
Base Kansas City	4135-1903
Pawnee	4223-1991
Ft. Scott	4306-2074
Cherokee	4328-2096
Mississippian	4382-2150
Osage	4398-2166
Total Depth	4440-2208

DST #1 (H) 4390-4406, open 1 hr.,
weak blow decreasing to very
weak. Recovered 10' thin watery
mud. ISIP 436#, 30 minutes.
FSIP 500#, 30 minutes. Both
pressures still building very
strongly. IFP 27#. FFP 27#.

D&A

RECEIVED
STATE CORPORATION COMMISSION
JUN 7 1968
CONSERVATION DIVISION
Wichita, Kansas