

STATE CORPORATION COMMISSION OF KANSAS
OIL & GAS CONSERVATION DIVISION
WELL COMPLETION OR RECOMPLETION FORM
ACO-1 WELL HISTORY
DESCRIPTION OF WELL AND LEASE

API NO. 15-NA
County... Stafford
S/2 N/2 NW/4 Sec. 27 Twp 21S Rge. 13 East West
4290 Ft North from Southeast Corner of Section
3960 Ft West from Southeast Corner of Section
(Note: Locate well in section plat below)
Lease Name... Linke Well # 2
Field Name... Gates
Producing Formation... Lansing/K.C.
Elevation: Ground... 1882' KB... 1888'

Operator: License # 5393
Name... A. L. Abercrombie, Inc.
Address... 801 Union Center
City/State/Zip... Wichita, KS 67202

Purchaser

Operator Contact Person... Jack K. Wharton
Phone... (316) 262-1841

Contractor: License # 5393
Name... A. L. Abercrombie, Inc.

Wellsite Geologist... Jack K. Wharton
Phone... (316) 262-1841

Designate Type of Completion

New Well Re-Entry Workover
Oil SWD Temp Abd
Gas Inj Delayed Comp.
Dry Other (Core, Water Supply etc.)

If OWO: old well info as follows:

Operator... Same
Well Name... Same
Comp. Date... 2/14/66 Old Total Depth... 3785'

WELL HISTORY


Drilling Method:

Mud Rotary Air Rotary Cable

1-27-66 2-8-66 2-14-66
Spud Date Date Reached TD Completion Date
3785'
Total Depth PBTD

Amount of Surface Pipe Set and Cemented at 273 feet
Multiple Stage Cementing Collar Used? Yes No
If yes, show depth set... feet
If alternate 2 completion, cement circulated from... feet depth to... w/... SX cmt
Cement Company Name
Invoice #

Section Plat

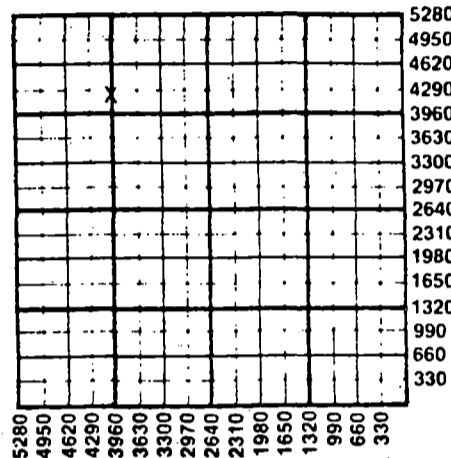

WATER SUPPLY INFORMATION

Disposition of Produced Water: Disposal
Docket # Repressuring

Questions on this portion of the ACO-1 call:
Water Resources Board (913) 296-3717

Source of Water:
Division of Water Resources Permit #
Groundwater... Ft North from Southeast Corner (Well) ... Ft West from Southeast Corner of Sec Twp Rge East West
Surface Water... Ft North from Southeast Corner (Stream, pond etc)... Ft West from Southeast Corner Sec Twp Rge East West
Other (explain) (purchased from city, R.W.D. #)


INSTRUCTIONS: This form shall be completed in triplicate and filed with the Kansas Corporation Commission, 200 Colorado Derby Building, Wichita, Kansas 67202, within 120 days of the spud date of any well. Rule 82-3-130, 82-3-107 and 82-3-106 apply.

Information on side two of this form will be held confidential for a period of 12 months if requested in writing and submitted with the form. See rule 82-3-107 for confidentiality in excess of 12 months. One copy of all wireline logs and driller's time log shall be attached with this form. Submit CP-4 form with all plugged wells. Submit CP-111 form with all temporarily abandoned wells.

All requirements of the statutes, rules and regulations promulgated to regulate the oil and gas industry have been fully complied with and the statements herein are complete and correct to the best of my knowledge.

Jack K. Wharton

President Date 6-13-86

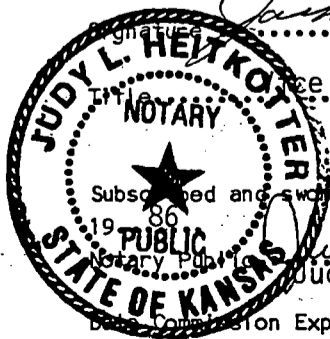

Subscribed and sworn to before me this 13th day of June 1986
Judy L. Heitkotter
Notary Public
Commission Expires 6-24-89

JUN 16 1986

CONSERVATION DIVISION
Wichita, Kansas

K.C.C. OFFICE USE ONLY

F Letter of Confidentiality Attached
C Wireline Log Received
C Driller's Timelog Received

Distribution

KCC SWD/Rep NGPA
 KGS Plug Other
(Specify)

Section 27, Twp 21S, Rge 13E