

This form shall be filed in duplicate with the Kansas Corporation Commission, 200 Colorado Derby Building, Wichita, Kansas 67202, within ten days after the completion of the well, regardless of how the well was completed.

Attach separate letter of request if the information is to be held confidential. If confidential, only file one copy. Information on side one will be of public record and side two will then be held confidential.

Circle one: Oil, Gas, Dry, SWD, OWVO, Injection. Type and complete ALL sections. Applications must be filed for dual completion, commingling, SWD and injection, T.A.

Attach wireline logs (i.e. electrical log, sonic log, gamma ray neutron log; etc.). KCC # (316) 263-3238. (Rules 82-2-105 & 82-2-125)

OPERATOR L. D. Davis

API NO. 15-185-21,564.0000

ADDRESS R. R. 1 Box 183 B

COUNTY STAFFORD

GREAT BEND, KANSAS 67530

FIELD WIDENER

**CONTACT PERSON L. D. Davis

PROD. FORMATION Kansas City

PHONE 316-793-3051

LEASE WIDENER

PURCHASER Koch Oil Company

WELL NO. 5

ADDRESS Wichita, Kansas

WELL LOCATION 100' West NE NE NE

DRILLING L.D. Drilling, Inc.

330 Ft. from North Line and

CONTRACTOR

430 Ft. from East Line of

ADDRESS R. R. 1 Box 183 B

the NE/4 SEC. 26 TWP. 21S RGE. 12 W.


Great Bend, Kansas 67530

WELL PLAT

PLUGGING

CONTRACTOR

ADDRESS

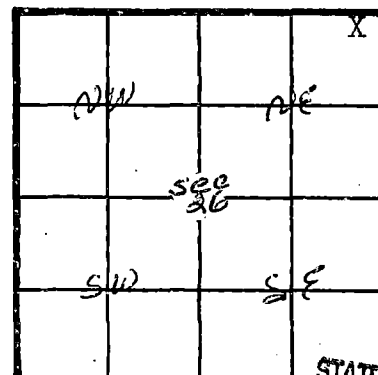

KCC KGS (Office Use)

TOTAL DEPTH 3635 PBT

SPUD DATE 4-27-82 DATE COMPLETED 5-4-82

ELEV: GR 1830' DF KB 1835'

DRILLED WITH (X) (ROTARY) (X) TOOLS

Amount of surface pipe set and cemented 299' DV Tool Used? MAY 19 1982

AFFIDAVIT

STATE OF Kansas, COUNTY OF Barton SS, I,

Don Popp OF LAWFUL AGE, BEING FIRST DULY SWORN UPON HIS OATH,

DEPOSES THAT HE IS Agent (FOR) (X) L. D. Davis

OPERATOR OF THE Widener LEASE, AND IS DULY AUTHORIZED TO MAKE

THIS AFFIDAVIT FOR AND ON THE BEHALF OF SAID OPERATOR, THAT WELL NO. 5 ON


SAID LEASE HAS BEEN COMPLETED AS OF THE 4th DAY OF May, 19 82, AND THAT

ALL INFORMATION ENTERED HEREIN WITH RESPECT TO SAID WELL IS TRUE AND CORRECT.

FURTHER AFFIANT SAITH NOT.

SUBSCRIBED AND SWORN BEFORE ME THIS 6th DAY OF May, 19 82

(S) Don Popp

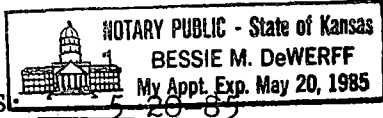

NOTARY PUBLIC Bessie M. DeWerff

MY COMMISSION EXPIRES 5-20-85

**The person who can be reached by phone regarding any questions concerning this information. Within 45 days of completion, a witnessed initial test by the Commission is required if the well produces more than 25 BOPD or is located in a Basic Order Pool.