

STATE OF KANSAS  
STATE CORPORATION COMMISSION

Form CP-4

Give All Information Completely  
Make Required Affidavit  
Mail or Deliver Report to:  
Conservation Division  
State Corporation Commission  
212 No. Market  
Wichita, Kansas 67202

WELL PLUGGING RECORD

Pawnee County, Sec. 32 Twp. 20S Rge. (E) 19 (W)

Location as "NE/CNW/SW" or footage from lines C SE SE

Lease Owner George Reed

Lease Name Freeland Well No. 1

Office Address 1223 Union Natl. Bldg., Wichita, Kansas

Character of Well (completed as Oil, Gas or Dry Hole) Dry Hole

Date well completed 7-6 19 71

Application for plugging filed 7-6 19 71

Application for plugging approved 7-6 19 71


Plugging commenced 7-6 19 71

Plugging completed 7-6 19 71

Reason for abandonment of well or producing formation No oil or gas found in commercial quantities.

If a producing well is abandoned, date of last production --- 19 --

Was permission obtained from the Conservation Division or its agents before plugging was commenced? Yes

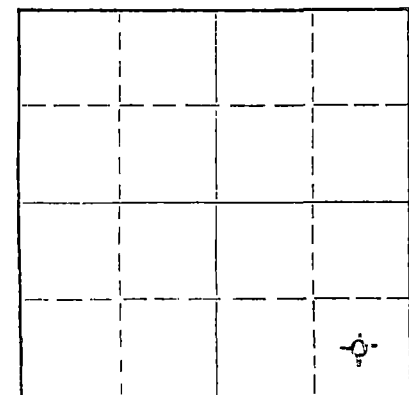

Locate well correctly on above Section Plat

Name of Conservation Agent who supervised plugging of this well Leo Massey

Producing formation \_\_\_\_\_ Depth to top \_\_\_\_\_ Bottom \_\_\_\_\_ Total Depth of Well 4285 Feet

Show depth and thickness of all water, oil and gas formations.

OIL, GAS OR WATER RECORDS

CASING RECORD

FORMATION	CONTENT	FROM	TO	SIZE	PUT IN	PULLED OUT
				8-5/8"	358'	-0-

Describe in detail the manner in which the well was plugged, indicating where the mud fluid was placed and the method or methods used in introducing it into the hole. If cement or other plugs were used, state the character of same and depth placed, from \_\_\_\_\_ feet to \_\_\_\_\_ feet for each plug set.

Squeezed 130 sacks 50-50 Poz., 2% Gel through surface pipe. Plugging completion time 8:00 a.m. 7-6-71.

RECEIVED  
STATE CORPORATION COMMISSION  
JUL 13 1971  
CONSERVATION DIVISION  
Wichita, Kansas

(If additional description is necessary, use BACK of this sheet)

Name of Plugging Contractor Rains & Williamson Oil Co., Inc.  
Address 435 Page Court, 220 W. Douglas, Wichita, Kansas


STATE OF KANSAS, COUNTY OF SEDGWICK, ss. Wilson Rains

(employee of owner) or (owner or operator) of the above-described well, being first duly sworn on oath, says: That I have knowledge of the facts, statements, and matters herein contained and the log of the above-described well as filed and that the same are true and correct. So help me God.

(Signature) Wilson Rains  
435 Page Court, 220 W. Douglas, Wichita, Ks.  
(Address)

Subscribed and sworn to before me this 8 day of July, 19 71

March 31, 1974  
Jeanine Durand Notary Public.

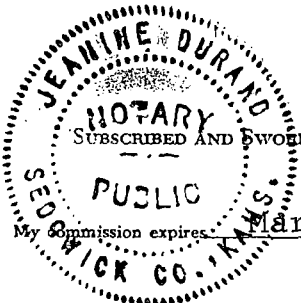

ROTARY DRILLING LOG

Operator: George Reed  
 FREELAND #1  
 C SE SE Section 32-20S-19W  
 Pawnee County, Kansas

Contractor: Rains & Williamson  
 Oil Co., Inc.  
 Commenced: 6-29-71  
 Completed: 7-6-71  
 Casing: 8-5/8"/358'/200 sacks

Formations

Surface Clay	70'
Sand and Shale	170'
Shale	720'
Sand	880'
Shale and Red Bed	1305'
Anhydrite	1329'
Shale	1560'
Shale and Lime	2090'
Lime and Shale	3595'
Lime	4285'
Rotary Total Depth	4285'

RECEIVED  
 STATE CORPORATION COMMISSION  
 JUL 13 1971  
 CONSERVATION DIVISION  
 Wichita, Kansas

We certify the above log is true and correct, to the best of our knowledge and belief.

RAINS & WILLIAMSON OIL CO., INC.

*Wilson Rains*  
 \_\_\_\_\_  
 Wilson Rains

Subscribed and sworn to before me, a Notary Public within and for the State of Kansas, County of Sedgwick, this 8 day of July, 1971.

*Jeanine Durand*  
 \_\_\_\_\_  
 Jeanine Durand Notary Public

My Commission Expires: 3-31-74

