


WELL PLUGGING RECORD

Give All Information Completely
Make Required Affidavit
Mail or Deliver Report to:
Conservation Division
State Corporation Commission
800 Biting Building
Wichita, Kansas

Pawnee County, Sec. 30 Twp 20 Rge 19 (E) (W)

Location as "NE/CNW%SW%" or footage from lines NW NW NW
Lease Owner Musgrove Petroleum Corporation
Lease Name DECHERT Well No. 1
Office Address 518 Petroleum Building, Wichita, Kansas.
Character of Well (completed as Oil, Gas or Dry Hole) Dry hole
Date well completed August 20, 1953
Application for plugging filed (verbal) August 20, 1953
Application for plugging approved " August 20, 1953
Plugging commenced August 20, 1953
Plugging completed August 20, 1953
Reason for abandonment of well or producing formation Dry hole

NORTH

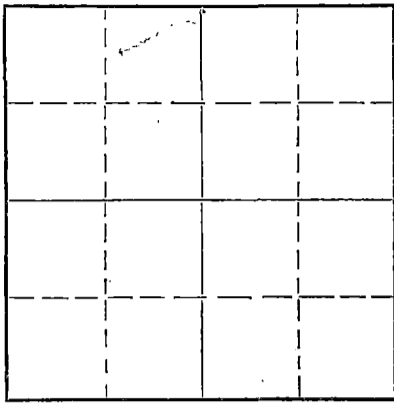

Locate well correctly on above
Section Plat

If a producing well is abandoned, date of last production 19
Was permission obtained from the Conservation Division or its agents before plugging was commenced? Yes

Name of Conservation Agent who supervised plugging of this well _____
Producing formation _____ Depth to top _____ Bottom _____ Total Depth of Well 4570' Feet
Show depth and thickness of all water, oil and gas formations.

OIL, GAS OR WATER RECORDS

CASING RECORD

FORMATION	CONTENT	FROM	TO	SIZE	PUT IN	PULLED OUT
				8-5/8"	341'	

Describe in detail the manner in which the well was plugged, indicating where the mud fluid was placed and the method or methods used in introducing it into the hole. If cement or other plugs were used, state the character of same and depth placed, from _____ feet to _____ feet for each plug set.

Set bottom plug at 300' with 20 sacks cement
Set top plug at 40' with 10 sacks cement

(If additional description is necessary, use BACK of this sheet)

Name of Plugging Contractor Musgrove Petroleum Corporation,
Address 518 Petroleum Building, Wichita, Kansas.

STATE OF Kansas, COUNTY OF Sedgwick, ss.
I, Gordon L. Keelling (employee of owner) or (owner/operator) of the above-described well, being first duly sworn on oath, says: That I have knowledge of the facts, statements, and matters herein contained and the log of the above-described well as filed and that the same are true and correct. So help me God.

(Signature) Gordon L. Keelling
518 Petroleum Building, Wichita, Kansas.
(Address)

SUBSCRIBED AND SWORN TO before me this 21st day of August 1953

My commission expires September 24, 1956

Thomas J. Stump
Notary Public

PLUGGING
FILE SEC 30 T 20 R 19W
BOOK PAGE 123 LINE 15

CONTRACTOR'S WELL LOG

COMPANY: Musgrove Petroleum Corporation
 CONTRACTOR: Musgrove Petroleum Corporation
 FARM: DECHERT #1
 LOCATION: NW NW NW Sec. 30-20-19
 Pawnee County, Kansas.
 COMMENCED: August 5, 1953
 COMPLETED: August 20, 1953

0	342	Sand & blue shale
342	550	Shale, gravel, red bed
550	640	Red bed & shale
640	670	Anhydrite
670	1195	Shale & shells, sand
1195	1200	Shale & shells
1200	1295	Sand, Pyrite, iron
1295	1445	Shale & lime
1445	1840	Shale, red bed, shells
1840	2144	Shale
2144	2264	Lime & shale, pyrite
2264	3838	Shale & lime
3838	4265	Lime
4265	4315	Chert & Conglomerate
4315	4340	Chert & lime
4340	4374	Mississippi lime
4374	4414	Mississippi Lime, Viola Dolomite
4414	4510	Viola Dolomite
4510	4540	Lime
4540	4570	Arbuckle
	4570	Rotary Total Depth

Set 8-5/8" surface casing at 341' with 175 sacks of cement.

Dry and Abandoned.

STATE OF KANSAS)
) SS
 COUNTY OF SEDGWICK)

I, GORDON L. KOELLING, do hereby certify that the above and foregoing is a true and correct copy of the log of the Dechert #1, NW NW NW, Section 30-20-19 Pawnee County, Kansas, as reflected by the files of the Musgrove Petroleum Corporation.

MUSGROVE PETROLEUM CORPORATION

BY Gordon L. Koelling
 Secretary-Treasurer

Subscribed and sworn to before me, a Notary Public, in and for Sedgwick County, Kansas, this 21st day of August, 1953.

Thomas L. Stinson
 Notary Public

My commission expires September 24, 1956.

