


STATE OF KANSAS  
STATE CORPORATION COMMISSION

WELL PLUGGING RECORD

Give All Information Completely  
Make Required Affidavit  
Mail or Deliver Report to  
Conservation Division  
State Corporation Comm.  
245 North Water  
Wichita, KS 67202

Ness County, Sec. 9 Twp. 20S Rge. 21 ~~X~~/W  
Location as "NE/CNW $\frac{1}{4}$ SW $\frac{1}{4}$ " or footage from lines  
C NE SE

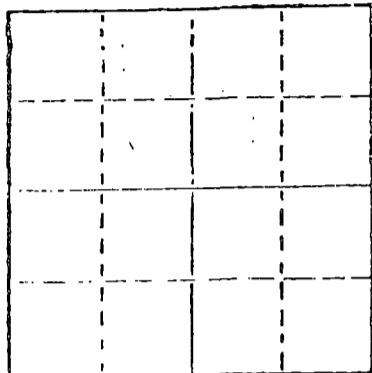

Locate well correctly on above  
Section Plot

Lease Owner Palomino Petroleum  
Lease Name Lowen Betz Well No. 1-W  
Office Address 500 Insurance Bldg., Wichita, Kansas 67202  
Character of Well (Completed as Oil, Gas or Dry Hole)  
dry hole - was old plugged oil well  
Date Well completed July 3, 1979  
Application for plugging filed July 2, 1979  
Application for plugging approved July 2, 1979  
Plugging commenced July 3, 1979  
Plugging completed July 3, 1979  
Reason for abandonment of well or producing formation  
Tried to make a SWDW but couldn't get below 700 feet.  
If a producing well is abandoned, date of last production  
See copy of old plugging record attached (same well) 19  
Was permission obtained from the Conservation Division or  
its agents before plugging was commenced? Yes

Name of Conservation Agent who supervised plugging of this well Marion Schmidt  
Producing formation None Depth to top Bottom Total Depth of Well 700  
Show depth and thickness of all water, oil and gas formations.

OIL, GAS OR WATER RECORDS

CASING RECORD

FORMATION	CONTENT	FROM	TO	SIZE	PUT IN	PULLED OUT
						None

Describe in detail the manner in which the well was plugged, indicating where the mud fluid was placed and the method or methods used in introducing it into the hold. If cement or other plugs were used, state the character of same and depth placed, from \_\_\_\_\_ feet to \_\_\_\_\_ feet for each plug set.

Squeezed with 150 sacks of 50-50 Pozmix, 6% gel, with a maximum pressure of 450#.  
Finished at 3:30 P.M. 7-3-79.

*(This was a good job)*  
*[Signature]*

(If additional description is necessary, use BACK of this sheet)

Name of Plugging Contractor \_\_\_\_\_ Company operation.

STATE OF KANSAS COUNTY OF SEDGWICK, ss.  
R. W. WATCHOUS (owner ~~XXXXXXXXXX~~)

of the above-described well, being first duly sworn on oath, says: That I have knowledge of the facts, statements, and matters herein contained and the log of the above-described well as filed and that the same are true and correct. So help me God.

(Signature) *[Signature]*  
500 Insurance Bldg., Wichita, Kansas 67202  
(Address)

SUBSCRIBED AND SWORN TO before me this 19th day of October, 1979



RECEIVED  
STATE CORPORATION COMMISSION  
*[Signature]*  
Notary Public.

My commission expires \_\_\_\_\_

OCT 23 1979  
10-22-79  
CONSERVATION DIVISION  
Wichita, Kansas

