

STATE OF KANSAS
STATE CORPORATION COMMISSION

WELL PLUGGING RECORD

Give All Information Completely
Make Required Affidavit
Mail or Deliver Report to:
Conservation Division
State Corporation Commission
212 No. Market
Wichita, Kansas

Ness County, Sec. 9 Twp. 20S Rge. 21 (X) (W)

Location as "NE/CNW/SW" or footage from lines 40' W of C SE SE

Lease Owner Mobil Oil Corporation

Lease Name Betz Estate Well No. 1

Office Address P. O. Box 1934, Oklahoma City, Oklahoma

Character of Well (completed as Oil, Gas or Dry Hole) Oil

Date well completed May 19 19 65

Application for plugging filed Feb. 20 19 68

Application for plugging approved Feb. 21 19 68


Plugging commenced Feb. 22 19 68

Plugging completed March 2 19 68

Reason for abandonment of well or producing formation
Production Depleted

If a producing well is abandoned, date of last production March 19 67

Was permission obtained from the Conservation Division or its agents before plugging was commenced? Yes

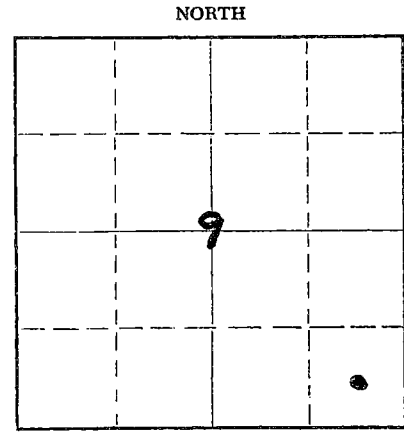

Locate well correctly on above Section Plat

Name of Conservation Agent who supervised plugging of this well Leo Massey
Producing formation Mississippi Depth to top 4424' Bottom 4431' Total Depth of Well 4431' Feet

Show depth and thickness of all water, oil and gas formations.

OIL, GAS OR WATER RECORDS

CASING RECORD

FORMATION	CONTENT	FROM	TO	SIZE	PUT IN	PULLED OUT
Heebner	Dry	3784'	3830'	5-1/2"	4415'	2961'
Lansing	"	3830'	4323'			
Cherokee	"	4323'	4393'			
Basal Penn. Cong.	"	4393'	4425'			
Miss. Osage	Oil	4425'	4431'			

Describe in detail the manner in which the well was plugged, indicating where the mud fluid was placed and the method or methods used in introducing it into the hole. If cement or other plugs were used, state the character of same and depth placed, from _____ feet to _____ feet for each plug set.

Dumped sand from 4431' up to 4400'. Ran 5 sacks of cement and filled up to 4376'. Shot pipe @ 3148', 3056' & 2962'. Pulled 2961' of 5-1/2" casing. Mud hole from 4376' to 500'. Rock bridge from 500' to 485'. Ran 5 sacks of cement and filled up 470'. Bailed hole to 470' and ran 25 sacks of cement from 470' to 395'. Mud from 395' to 50'. Rock bridge and 5 sacks of cement from 40' to base of cellar.

RECEIVED
STATE CORPORATION COMMISSION
MAR 25 1968
CONSERVATION DIVISION
Wichita, Kansas

(If additional description is necessary, use BACK of this sheet)

Name of Plugging Contractor Glenn & Smith Pulling Company
Address 204 East 6th Street, Ellinwood, Kansas 67526

STATE OF Oklahoma, COUNTY OF Oklahoma, ss.
Paul K. Langenberg (employee of owner) or (owner or operator) of the above-described well, being first duly sworn on oath, says: That I have knowledge of the facts, statements, and matters herein contained and the log of the above-described well as filed and that the same are true and correct. So help me God.

(Signature) Paul K. Langenberg
P. O. Box 1934, Oklahoma City, Oklahoma
(Address)

SUBSCRIBED AND SWORN TO before me this 22nd day of March, 19 68

M. J. Zander
Notary Public.

My commission expires September 8, 1971

DRILLER'S LOG

COMPANY
CONTRACTOR
FARM
LOCATION

Mobil Oil Company
LEBEN DRILLING, INC.
Betz Estate #1
C SE SE Sec. 9-20s-21w
Ness County, Kansas
5-15-65
5-16-65

COMMENCED
COMPLETED

0	380	Sand and Clay
380	505	Clay and Shale
505	600	Shale
600	900	Shale and Red Bed
900	1120	Sand
1120	1478	Shale
1478	1502	Anhydrite
1502	2765	Shale and Lime
2765	2780	Lime and Shale
2780	3596	Shale and Chalky Lime
3596	3633	Chalky Lime
3633	3750	Shale and Lime
3750	3819	Lime and Shale
3819	4431	Lime
	4431	Rotary Total Depth - Set 5 1/2" casing @ 4424'

RECEIVED
STATE CORPORATION COMMISSION
APR 24 1968
CONSERVATION DIVISION
Wichita, Kansas

I, Leslie Kite, do hereby certify that the above and foregoing is a true and correct copy of the log of the Betz Estate #1, located C SE SE of Section 9, Township 20 South, Range 21 West, Ness County, Kansas, as reflected by the files of Leben Drilling, Inc.

Leslie Kite

Leslie Kite

STATE OF KANSAS)
) SS
COUNTY OF BARTON)

Subscribed and sworn to before me, a Notary Public, in and for Barton County, Kansas, this 20th day of May, 1965.

Ulanda Nichols

Ulanda Nichols, Notary Public

My commission expires, April 1, 1967