


STATE OF KANSAS  
STATE CORPORATION COMMISSION

WELL PLUGGING RECORD

Give All Information Completely  
Make Required Affidavit  
Mail or Deliver Report to  
Conservation Division  
State Corporation Comm.  
245 North Water  
Wichita, KS 67202

Pawnee County. Sec. 26 Twp. 20S Rge. 20W E/W  
Location as "NE/CNW $\frac{1}{4}$ SW $\frac{1}{4}$ " or footage from lines \_\_\_\_\_  
100' North of SW NE SW  
Lease Owner D. R. Lauck Oil Company, Inc.  
Lease Name Tombaugh Well No. 1  
Office Address 221 S. Broadway, Suite 400, Wichita, KS 67202  
Character of Well (Completed as Oil, Gas or Dry Hole) \_\_\_\_\_

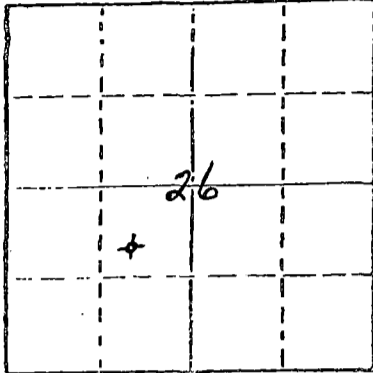

Locate well correctly on above  
Section Plot

Dry Hole  
Date Well completed September 22, 1981  
Application for plugging filed September 22, 1981  
Application for plugging approved September 22, 1981  
Plugging commenced September 22, 1981  
Plugging completed September 22, 1981  
Reason for abandonment of well or producing formation \_\_\_\_\_  
Dry Hole

If a producing well is abandoned, date of last production \_\_\_\_\_ 19\_\_\_\_

Was permission obtained from the Conservation Division or its agents before plugging was commenced? Yes

Name of Conservation Agent who supervised plugging of this well Steve Durrant  
Producing formation \_\_\_\_\_ Depth to top \_\_\_\_\_ Bottom \_\_\_\_\_ Total Depth of Well 4320'  
Show depth and thickness of all water, oil and gas formations.

OIL, GAS OR WATER RECORDS

CASING RECORD

FORMATION	CONTENT	FROM	TO	SIZE	PUT IN	PULLED OUT
		0'	345'	8-5/8"	338.64'	None

Describe in detail the manner in which the well was plugged, indicating where the mud fluid was placed and the method or methods used in introducing it into the hold. If cement or other plugs were used, state the character of same and depth placed, from \_\_\_\_\_ feet to \_\_\_\_\_ feet for each plug set.

Plugged with 70 sacks cement at 780';  
40 sacks cement at 330'; 10 sacks cement  
at 40'; and 5 sacks cement in rat hole.


(If additional description is necessary, use BACK of this sheet)

Name of Plugging Contractor Allied Cementing Co.

STATE OF KANSAS COUNTY OF SEDGWICK, ss.  
John D. Knightley (employee of owner) or (owner or operator)  
of the above-described well, being first duly sworn on oath, says: That I have knowledge of the facts, statements, and matters herein contained and the log of the above-described well as filed and that the same are true and correct. So help me God.

(Signature) [Signature]  
221 S. Broadway, Suite 400, Wichita, KS 67202  
(Address)

SUBSCRIBED AND SWORN TO before me this 5th day of October, 19 81

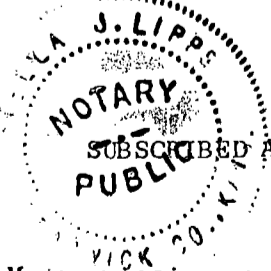

Stella J. Lipps  
Notary Public.

My commission expires March 12, 1983

RECEIVED  
STATE CORPORATION COMMISSION  
10-7-81  
OCT 7 1981  
CONSERVATION DIVISION  
Wichita, Kansas

15.145.20900.0000

D. R. Lauck Oil Company, Inc. - Tombaugh #1, 100' North of  
221 S. Broadway, Suite 400 SW NE SW Sec. 26-20S-20W  
Wichita, Kansas 67202 Pawnee County, Kansas

Contractor: D. R. Lauck Oil Company, Inc.  
221 S. Broadway, Suite 400  
Wichita, Kansas 67202

Commenced: September 16, 1981  
Completed: September 22, 1981

Drillers Log

Top Soil & Sand	60
Brown Clay	215
Red Bed	350
Blue Shale	518
Red Bed & Shells	1240
Red Bed	1292
Anhydrite	1319
Shale	1885
Shale & Shells	3870
Shale & Lime	4170
Lime & Shale	4320 RTD