


STATE OF KANSAS
STATE CORPORATION COMMISSION

Give All Information Completely
Make Required Affidavit
Mail or Deliver Report to:
Conservation Division
State Corporation Commission
211 No. Broadway
Wichita, Kansas

WELL PLUGGING RECORD

SP

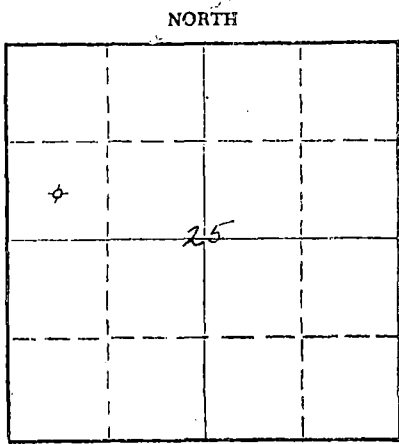

Locate well correctly on above Section Plat

Pawnee County, Sec. 25 Twp. 20S Rge. 20W ~~(XXXXXXXXXX)~~

Location as "NE/CNW/SW" or footage from lines C SW NW

Lease Owner Mull Drilling Co., Inc.

Lease Name Haas Well No. 1

Office Address 1625 Wichita Plaza, Wichita, Kans.

Character of Well (completed as Oil, Gas or Dry Hole) Dry Hole

Date well completed November 24 1966

Application for plugging filed November 24 1966

Application for plugging approved November 24 1966

Plugging commenced November 25 1966

Plugging completed November 25 1966

Reason for abandonment of well or producing formation Oil in commercial quantities not found.

If a producing well is abandoned, date of last production 19

Was permission obtained from the Conservation Division or its agents before plugging was commenced? Yes

Name of Conservation Agent who supervised plugging of this well Don Truan

Producing formation - - Depth to top - - Bottom - - Total Depth of Well 4370 Feet

Show depth and thickness of all water, oil and gas formations.

OIL, GAS OR WATER RECORDS

CASING RECORD

FORMATION	CONTENT	FROM	TO	SIZE	PUR IN	PULLED OUT
				8 5/8"	480'	None

Describe in detail the manner in which the well was plugged, indicating where the mud fluid was placed and the method or methods used in introducing it into the hole. If cement or other plugs were used, state the character of same and depth placed, from feet to feet for each plug set.

Filled hole with heavy rotary mud to 400'.
Set bottom plug at 400' W/ 25 Sx. Cement, 1/4 Sk. Hulls.
Top Plug at 40' W/10 Sx. Cement, 1/2 Sk. Hulls. 2 Sx.
cement in rat hole.

RECEIVED
NOV 30 1966
11-30-66
CONSERVATION DIVISION
Wichita, Kansas

(If additional description is necessary, use BACK of this sheet)

Name of Plugging Contractor Vaughan Drilling, Inc.
Address 1618 Wichita Plaza, Wichita, Kansas

STATE OF Kansas COUNTY OF Sedgwick, ss.
Donald D. Vaughan

(employee of owner) or (owner or operator) of the above-described well, being first duly sworn on oath, says: That I have knowledge of the facts, statements, and matters herein contained and the log of the above-described well as filed and that the same are true and correct. So help me God.

(Signature) Donald D. Vaughan
1618 Wichita Plaza, Wichita, Kansas
(Address)

Subscribed and Sworn to before me this 29th day of November, 1966



Marguerite Mayfield
Notary Public.

VAUGHAN DRILLING, INC.

1618 Wichita Plaza, Wichita, Kansas

WELL LOG

COMPANY: Mull Drilling Co., Inc.
 CONTRACTOR: Vaughan Drilling, Inc.
 FARM: #1 Haas
 LOCATION: C SW NW Sec. 25-20S-20W
 Pawnee County, Kansas
 ELEVATION: 2209 Kelly Bushing
 SURFACE PIPE: Set 480' of 8 5/8" W/250 Sx. Cement
 COMMENCED: November 15, 1966
 COMPLETED: November 24, 1966

DEPTH	FORMATION	SAMPLE TOPS
0 - 480	Clay, Shale & Shells	Anhydrite 1340
480 - 805	Shale	Base Anhydrite 1370
805 - 1025	Sand	Tarkio 3141
1025 - 1150	Sand Streaks & Shale	Heebner 3687
1150 - 1340	Red Bed	Lansing 3738
1340 - 1370	Anhydrite	Drum 3917
1370 - 1400	Red Bed	Base Kansas City 4069
1400 - 2100	Shale & Shells	Cherokee 4231
2100 - 2255	Shale & Lime Streaks	Eros. Mississippi 4359
2255 - 3847	Lime & Shale	Rotary Total Depth 4370
3847 - 4210	Lime	
4210 - 4254	Shale, Lime & Sand	
4254 - 4260	Lime & Sand	
4260 - 4285	Lime	
4285 - 4370	Shale & Lime	

AFFIDAVIT

STATE OF KANSAS)
) SS
 COUNTY OF SEDGWICK)

I, Donald D. Vaughan, President of Vaughan Drilling, Inc., being first duly sworn on oath, state: That I have knowledge of the facts, statements and matters herein contained and that the same are true and correct.

Donald D. Vaughan
 Donald D. Vaughan

Subscribed and sworn to before me this 29th day of November, 1966.

Marguerite Mayfield
 Marguerite Mayfield, Notary Public

My Comm. Expires: 10-26-69

