


STATE OF KANSAS
STATE CORPORATION COMMISSION

WELL PLUGGING RECORD

Give All Information Completely
Make Required Affidavit
Mail or Deliver Report to
Conservation Division
State Corporation Comm.
245 North Water
Wichita, KS 67202

Pawnee County. Sec. 23 Twp. 20S Rge. 20W xxw
Location as "NE/CNW $\frac{1}{4}$ SW $\frac{1}{4}$ " or footage from lines _____
C NW NE
Lease Owner Hummon Corporation
Lease Name Jennings Well No. 1
Office Address 400 One Main Place, Wichita, Ks. 67202
Character of Well (Completed as Oil, Gas or Dry Hole) _____

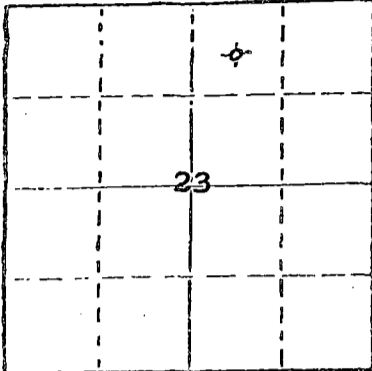

Locate well correctly on above
Section Plot

Dry Hole
Date Well completed September 3, 1979
Application for plugging filed September 3, 1979
Application for plugging approved September 3, 1979
Plugging commenced September 3, 1979
Plugging completed September 3, 1979
Reason for abandonment of well or producing formation _____

Dry Hole
If a producing well is abandoned, date of last production _____ 19____

Was permission obtained from the Conservation Division or its agents before plugging was commenced? Yes

Name of Conservation Agent who supervised plugging of this well Leo F. Massey
Producing formation _____ Depth to top _____ Bottom _____ Total Depth of Well 4330'
Show depth and thickness of all water, oil and gas formations.

OIL, GAS OR WATER RECORDS

CASING RECORD

FORMATION	CONTENT	FROM	TO	SIZE	PUT IN	PULLED OUT
		0'	460'	8-5/8"	453.19'	None

Describe in detail the manner in which the well was plugged, indicating where the mud fluid was placed and the method or methods used in introducing it into the hold. If cement or other plugs were used, state the character of same and depth placed, from _____ feet to _____ feet for each plug set.

Plugged with 60 sacks cement at 600',
30 sacks cement at 450', 10 sacks cement
and plug at 40', and 5 sacks cement in
rat hole. (50-50 Pozmix Cement, 6% Gel)

RECEIVED
STATE CORPORATION COMMISSION
SEP 17 1979
CLERK-VALUATION DIVISION
Wichita, Kansas

(If additional description is necessary, use BACK of this sheet)

Name of Plugging Contractor Allied Cementing Co.


STATE OF KANSAS COUNTY OF SEDGWICK, ss.
John D. Knightley Agent (employee of owner) or (owner or operator)
of the above-described well, being first duly sworn on oath, says: That I have knowledge of the facts, statements, and matters herein contained and the log of the above-described well as filed and that the same are true and correct. So help me God.

(Signature) [Signature]
221 S. Broadway, Wichita, Kansas 67202
(Address)

SUBSCRIBED AND SWORN TO before me this 14th day of September, 1979

[Signature]
Notary Public.

My commission expires March 12, 1983

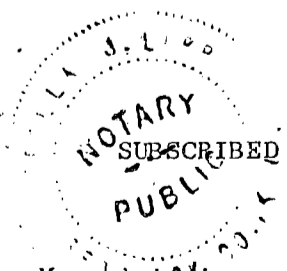

15.145.20593.0000

Hummon Corporation
400 One Main Place
Wichita, Kansas 67202

-

Jennings #1
C NW NE Sec. 23-20S-20W
Pawnee County, Kansas

Contractor: D. R. Lauck Oil Company, Inc.
221 S. Broadway, Suite 400
Wichita, Kansas 67202

Commenced: August 27, 1979
Completed: September 3, 1979

Drillers Log

Post Rock & Blue Shale	310
Red Bed	750
Sand	970
Anhydrite	1358
Red Bed & Shale	1610
Shale & Shells	3180
Shale & Lime	3860
Lime	3965
Lime & Shale	4244
Lime & Chert	4330 RTD

RECEIVED
STATE CORPORATION COMMISSION

SEP 17 1979

CONSERVATION DIVISION
Wichita, Kansas