

STATE OF KANSAS
STATE CORPORATION COMMISSION

Form CP-4

WELL PLUGGING RECORD

Give All Information Completely
Make Required Affidavit
Mail or Deliver Report to:
Conservation Division
State Corporation Commission
212 No. Market
Wichita, Kansas

Pawnee County, Sec. 9 Twp. 20S Rge. (E) 20 (W)

Location as "NE/CNW/SE" or footage from lines C NE SE

Lease Owner Pickrell Drilling Company

Lease Name Lanterman, "A" Well No. 1

Office Address 705 Fourth National Bank Bldg., Wichita, Kansas

Character of Well (completed as Oil, Gas or Dry Hole) Dry Hole

Date well completed April 3, 1967

Application for plugging filed April 3, 1967

Application for plugging approved April 3, 1967


Plugging commenced April 3, 1967

Plugging completed April 3, 1967

Reason for abandonment of well or producing formation Dry Hole

If a producing well is abandoned, date of last production 19

Was permission obtained from the Conservation Division or its agents before plugging was commenced? Yes

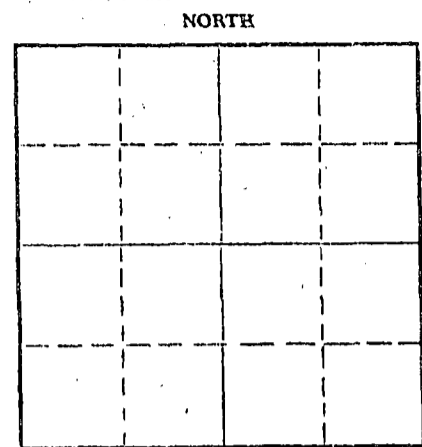

Name of Conservation Agent who supervised plugging of this well Leo Massey, Hays, Kansas

Producing formation Depth to top Bottom Total Depth of Well 4341 Feet

Show depth and thickness of all water, oil and gas formations.

OIL, GAS OR WATER RECORDS

CASING RECORD

FORMATION	CONTENT	FROM	TO	SIZE	PUT IN	PULLED OUT
				8 5/8"	281'	None

Describe in detail the manner in which the well was plugged, indicating where the mud fluid was placed and the method or methods used in introducing it into the hole. If cement or other plugs were used, state the character of same and depth placed, from feet to feet for each plug set.

Heavy mud to 550'. Set plug. Cemented with
25 sacks cement. Heavy mud to 260'. Set plug.
Cemented with 20 sacks cement. Heavy mud to 40'.
Set plug. Cemented with 10 sacks cement to bottom
of cellar. Plugged rat hole with 2 sacks cement.

(If additional description is necessary, use BACK of this sheet)

Name of Plugging Contractor Pickrell Drilling Company
Address 705 Fourth National Bank Bldg., Wichita, Kansas 67202

STATE OF KANSAS, COUNTY OF SEDGWICK, ss.
C. W. Sebitts (owner or operator) of the above-described

well being first duly sworn on oath, says: That I have knowledge of the facts, statements, and matters herein contained and the log of the well as filed and that the same are true and correct. So help me God.

(Signature) C. W. Sebitts
705 Fourth National Bank Bldg., Wichita, Ks.
(Address)

Sworn to before me this 10th day of April, 1967

My commission expires May 10, 1970

L. M. Whiting
Notary Public.

Notary Public.

ROTARY DRILLING LOG

15.145.20005.0000

COMPANY: Pickrell Drilling Company
705 Fourth National Bank Bldg.
Wichita, Kansas 67202

Rotary Drilling Commenced 3/24/67

Rotary Drilling Completed 4/3/67

LOCATION: Lanterman "A" No. 1
C NE SE Section 9-20S-20W-
Pawnee County, Kansas

CONTRACTOR: **PICKRELL DRILLING COMPANY**
Wichita, Kansas

CASING RECORD: (13 Jts.) 8 5/8" surface casing set @ 280' and cemented with 165 sacks cement. Circulated. Completed @ 10:00 PM, 3/24/67. No oil string was run. D. & A. @ 2:45 PM, 4/3/67.

LOG

(Figures indicate bottom of formation -- measurements from top of rotary bushing.)

100	Post Rock	<u>C.F.S.</u>
360	Shale, Shells & Sand Streaks	4220
560	Shale	4240
704	Red Beds & Shale	4247
710	Blaine	4267
805	Red Beds	4280
1010	Sand	4295
1365	Red Beds, Shale & Shells	4300
1395	Anhydrite	4310
1560	Shale & Shells	4317
2150	Shale	
2455	Lime & Shale	
2650	Lime	
3360	Shale & Lime	<u>Slope Tests</u>
3487	Sandy Lime & Shale	2500
3890	Lime & Shale	3000
4018	Lime	3500
4295	Lime & Shale	4000
4300	Sand	
4340	Mississippian, RTD	
4341	Log Total Depth	

S.L.M.
4018

RECEIVED
STATE CORPORATION COMMISSION
APR 12 1967
CONSERVATION DIVISION
Wichita, Kansas

The undersigned, C. W. SEBITS, Attorney-in-Fact for PICKRELL DRILLING COMPANY, hereby certifies in behalf of said Company, that the above is a true and correct log of the formation encountered in drilling the above well as reflected by the Daily Drilling Reports.

PICKRELL DRILLING COMPANY

By [Signature]
C. W. SEBITS, Attorney-in-Fact

STATE OF KANSAS }
COUNTY OF SEDGWICK } ss.:

On this 10th day of April, 1967, before me the undersigned, a Notary Public, in and for the County and State aforesaid, personally appeared C. W. SEBITS, to me known to be the identical person who subscribed the name of PICKRELL DRILLING COMPANY to the foregoing instrument as its Attorney-in-Fact and acknowledged to me that he executed the same as his free and voluntary act and deed, and as the free and voluntary act and deed of such company, for the uses and purposes therein set forth.

Given under my hand and seal of office the day and year last above written.

My commission expires: May 10, 1970

[Signature]
L. M. Whiting Notary Public