


STATE OF KANSAS  
STATE CORPORATION COMMISSION

WELL PLUGGING RECORD

Give All Information Completely  
Make Required Affidavit  
Mail or Deliver Report to  
Conservation Division  
State Corporation Comm.  
245 North Water  
Wichita, KS 67202

Ness County, Sec. 8 Twp. 20S Rge. 21 E/W  
Location as "NE/CNW $\frac{1}{4}$ SW $\frac{1}{4}$ " or footage from lines  
150' E of C SW NE

Lease Owner Gear Petroleum Company, Inc.  
Lease Name North 'A' Well No. 2  
Office Address 300 Sutton Place, Wichita, 67202  
Character of Well (Completed as Oil, Gas or Dry Hole)  
Dry Hole

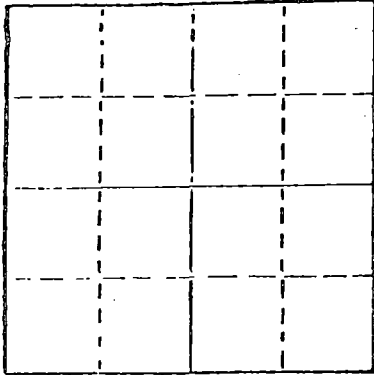

Locate well correctly on above  
Section Plat

Date Well completed 11/12/79 19  
Application for plugging filed 11/12/79 19  
Application for plugging approved 11/12/79 19  
Plugging commenced 11/12/79 19  
Plugging completed 11/12/79 19  
Reason for abandonment of well or producing formation

If a producing well is abandoned, date of last production 19

Was permission obtained from the Conservation Division or its agents before plugging was commenced? Yes

Name of Conservation Agent who supervised plugging of this well Leo Massey  
Producing formation \_\_\_\_\_ Depth to top \_\_\_\_\_ Bottom \_\_\_\_\_ Total Depth of Well \_\_\_\_\_  
Show depth and thickness of all water, oil and gas formations. TD 4452'

OIL, GAS OR WATER RECORDS

CASING RECORD

FORMATION	CONTENT	FROM	TO	SIZE	PUT IN	PULLED OUT
	Surface	0	288	8-5/8"	yes	no

Describe in detail the manner in which the well was plugged, indicating where the mud fluid was placed and the method or methods used in introducing it into the hold. If cement or other plugs were used, state the character of same and depth placed, from \_\_\_\_\_ feet to \_\_\_\_\_ feet for each plug set.

1st plug @ 775' with 70 sacks  
2nd plug @ 270' with 20 sacks  
3rd plug @ 40' with 5 sacks  
5 sacks in rathole  
Job complete @ 2:45 p.m. 11/12/79

RECEIVED  
STATE CORPORATION COMMISSION  
NOV 20 1979

CONSERVATION DIVISION  
Wichita, Kansas

(If additional description is necessary, use BACK of this sheet)

Name of Plugging Contractor Slawson Drilling Company, Inc.

STATE OF Kansas COUNTY OF Sedgwick, ss.  
James C. Remsberg, Slawson Drilling Co., Inc. (employee of owner) or (owner or operator) of the above-described well, being first duly sworn on oath, says: That I have knowledge of the facts, statements, and matters herein contained and the log of the above-described well as filed and that the same are true and correct. So help me God.

(Signature) James C. Remsberg  
James C. Remsberg  
200 Douglas Building, Wichita, Kansas 67202  
(Address)

SUBSCRIBED AND SWORN TO before me this 16th day of November, 1979

Mary Lou Taylor  
Mary Lou Taylor Notary Public.

My commission expires January 17, 1981



DRILLERS LOG

OPERATOR: Gear Petroleum Company, Inc.  
 300 Sutton Place  
 Wichita, Kansas 67202

LEASE: North 'A' #2  
 150' E of C SW NE Sec. 8-20S-21W  
 Ness County, Kansas

CONTRACTOR: Slawson Drilling Company, Inc.  
 200 Douglas Building  
 Wichita, Kansas 67202

NOISSIWINNO COMMISSION RECEIVED  
 6/16/1979  
 COMPLETED: 11/5/79  
 11/12/79  
 RTD: 4452'

SURFACE CASING: 8-5/8" set at 288' with 225 sx cement

0' to 294' 12 1/4" Surface Hole  
 294' to 413' Shale  
 413' to 1358' Shale & Sand  
 1358' to 3230' Shale  
 3230' to 3430' Lime & Shale  
 3430' to 3855' Shale & Lime  
 3855' to 4018' Lime & Shale  
 4018' to 4265' Shale & Lime  
 4265' to 4386' Lime & Shale  
 4386' to 4452' Shale & Lime  
 RTD 4452'

STATE OF KANSAS

COUNTY OF SEDGWICK

I, James C. Remsberg, of the Slawson Drilling Company, Inc. hereby state the above and foregoing is an accurate copy of the North 'A' #2 log for Gear Petroleum Company, Inc.

*James C. Remsberg*  
 James C. Remsberg

Subscribed and sworn to me this 16th day of November, 1979

*Mary Lou Taylor*  
 Mary Lou Taylor, Notary

My commission expires January 17, 1981

