


WELL PLUGGING RECORD

Give All Information Completely
Make Required Affidavit
Mail or Deliver Report to:
Conservation Division
State Corporation Commission
212-No. Market
Wichita, Kansas

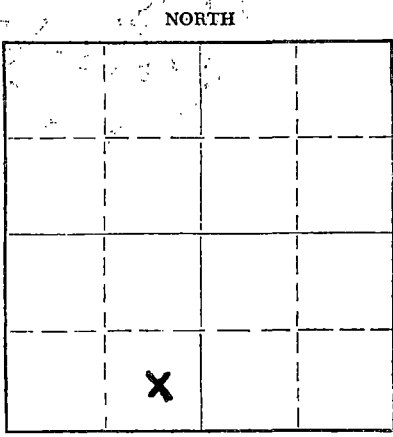

Locate well correctly on above Section Plat

Ness County, Sec. 8 Twp. 20 Rge. 21 (E) (W)
Location as "NE/CNW/SW" or footage from lines C SE SW
Lease Owner Pickrell Drilling Company
Lease Name Yount B. Well No. #1
Office Address 705 Fourth National Bank Bldg., Wichita, Ks.
Character of Well (completed as Oil, Gas or Dry Hole) Dry Hole
Date well completed June 1 1969
Application for plugging filed June 19 1969
Application for plugging approved June 23 1969
Plugging commenced June 23 1969
Plugging completed 3:30 P.M. June 25 1969
Reason for abandonment of well or producing formation Dry Hole

If a producing well is abandoned, date of last production _____ 19____
Was permission obtained from the Conservation Division or its agents before plugging was commenced? Yes

Name of Conservation Agent who supervised plugging of this well Don Truan
Producing formation _____ Depth to top _____ Bottom _____ Total Depth of Well 4453 Feet
Show depth and thickness of all water, oil and gas formations.

OIL, GAS OR WATER RECORDS CASING RECORD

FORMATION	CONTENT	FROM	TO	SIZE	PUT IN	PULLED OUT
				8 5/8	267	None
				5 1/2	4448	3527

RECEIVED
STATE CORPORATION COMMISSION
JUL 2 1969
CONSERVATION DIVISION
Wichita, Kansas

Describe in detail the manner in which the well was plugged, indicating where the mud fluid was placed and the method or methods used in introducing it into the hole. If cement or other plugs were used, state the character of same and depth placed, from _____ feet to _____ feet for each plug set.

6 - 23 - 69 Dumped sand to 4430'. Mixed and dumped 5 sx of cement from 4430' to 4390'.
6 - 25 - 69 Mixed and pumped 2 sx of hulls, 10 sx of gel and 130 sx of cement down 8 5/8 surface casing.
Completed at 3:30 p.m.
Standing pressure 100 lbs.

(If additional description is necessary, use BACK of this sheet)
Name of Plugging Contractor Russ Casing Pulling, Inc.
Address P.O. Box 1082 Great Bend, Kansas 67530

STATE OF Kansas, COUNTY OF Sedgwick, ss.
Dale M. Robinson (employee of owner) or (owner or operator) of the above-described well, being first duly sworn on oath, says: That I have knowledge of the facts, statements, and matters herein contained and the log of the above-described well as filed and that the same are true and correct. So help me God.

(Signature) Dale M. Robinson
Dale M. Robinson, Partner
705 Fourth National Bank Bldg., Wichita, Ks.
(Address)



Subscribed and sworn to before me this 1st day of July, 1969
Esther Lamone
Esther Lamone Notary Public.

ROTARY DRILLING LOG

COMPANY: Pickrell Drilling Company
705 4th National Bank Bldg.
Wichita, Kansas

Rotary Drilling Commenced 5/23/69

Rotary Drilling Completed 6/1/69

LOCATION: Yount B-1, C SE SW Sec. 8-20S-21W
Ness County, Kansas

CONTRACTOR: PICKRELL DRILLING COMPANY
Wichita, Kansas

CASING RECORD:

Ran 7 jts. 8-5/8" casing set @ 267' KB. Cemented with 160 sacks.
Completed 8 P.M. May 23, 1969. Circulated.

Ran 141 jts. 5-1/2" 14# & 15.5# casing set 3' off bottom @ 4448'.
Cemented with 125 Sacks Pozmix 4% gel followed by 35 sacks common.
Completed 7 P.M. June 1, 1969.

LOG

(Figures indicate bottom of formation — measurements from top of rotary bushing.)

90	Shale & Shells		C. F. S.
170	Post Rock		4420
267	Shale & Shells		4432
610	Shale		4440
930	Shale & Red Bed		4445
1135	Sand		4450
1495	Shale & sand stringers		4453
1538	Anhydrite		
2310	Shale		
2760	Lime & Shale		
3635	Shale & Lime		S. L. M.
4010	Sandy Lime & Shale		
4090	Shale & Lime Sandy	Strap	4210.21
4365	Lime & Shale	Board	<u>4208.82</u>
4453	Lime & Shale & Sand RTD		1.39 Difference

Slope Tests

- 2000
- 2500
- 3000
- 3500
- 4000

RECEIVED
STATE CORPORATION COMMISSION
JUN 23 1969
CONSERVATION DIVISION
Wichita, Kansas

The undersigned, C. W. Sebitts, Attorney-in-Fact for PICKRELL DRILLING COMPANY, hereby certifies in behalf of said Company, that the above is a true and correct log of the formation encountered in drilling the above well as reflected by the Daily Drilling Reports.

PICKRELL DRILLING COMPANY

By C. W. Sebitts Attorney-in-Fact

STATE OF KANSAS }
COUNTY OF SEDGWICK } ss.:

On this WHOTH day of June, 19 69, before me the undersigned, a Notary Public, in and for the State of Kansas, personally appeared C. W. Sebitts, to me known to be the person who subscribed the name of PICKRELL DRILLING COMPANY to the foregoing instrument as its Attorney-in-Fact and acknowledged to me that he executed the same as his free and voluntary act and deed, and as the free and voluntary act and deed of such company, for the uses and purposes therein set forth.

Given under my hand and seal of office the day and year last above written.

My commission expires: May 10, 1970

L.M. Whiting
L.M. Whiting Notary Public

