


Give All Information Completely
Make Required Affidavit
Mail or Deliver Report to:
Conservation Division
State Corporation Commission
212 No. Market
Wichita, Kansas

WELL PLUGGING RECORD

Ness County. Sec. 18 Twp. 20S Rge. 21W (X) (W)

Location as "NE/CNW/SW" or footage from lines C SW SE
Lease Owner Mobil Oil Corporation
Lease Name S. Schwein Well No. 1
Office Address Box 1828, Oklahoma City, Okla. 73101
Character of Well (completed as Oil, Gas or Dry Hole) Dry Hole
Date well completed 2-9-67 19
Application for plugging filed 2-9-67 19
Application for plugging approved 2-9-67 19
Plugging commenced 2-9-67 19
Plugging completed 2-9-67 19
Reason for abandonment of well or producing formation Dry Hole

NORTH

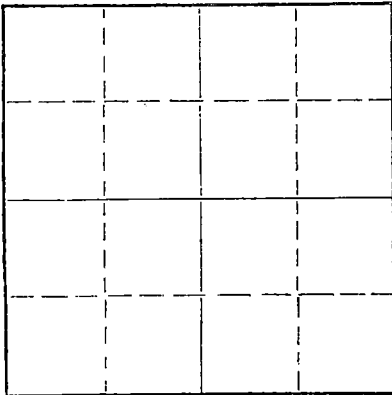

Locate well correctly on above Section Plat

If a producing well is abandoned, date of last production 19
Was permission obtained from the Conservation Division or its agents before plugging was commenced? yes

Name of Conservation Agent who supervised plugging of this well Leo Massey, Hays, Kansas
Producing formation _____ Depth to top _____ Bottom _____ Total Depth of Well 4500 Feet
Show depth and thickness of all water, oil and gas formations.

OIL, GAS OR WATER RECORDS

CASING RECORD

FORMATION	CONTENT	FROM	TO	SIZE	PUT IN	PULLED OUT
				8 5/8"	522'	none

Describe in detail the manner in which the well was plugged, indicating where the mud fluid was placed and the method or methods used in introducing it into the hole. If cement or other plugs were used, state the character of same and depth placed, from _____ feet to _____ feet for each plug set.

Mud to 480' - plug - 1/4 sk. hulls, 30 sks. cement through drill pipe
Mud to 40' - plug - 1/2 sk. hulls, 10 sks. cement
2 sks. cement in rathole

RECEIVED
FEB 15 1967
2-15-67
CONSERVATION DIVISION
Wichita, Kansas

(If additional description is necessary, use BACK of this sheet)

Name of Plugging Contractor Leben Drilling, Inc.
Address Box 486, Great Bend, Kansas 67530

STATE OF KANSAS, COUNTY OF BARTON, ss.
Leslie Kite (employee of owner) or (owner or operator) of the above-described well, being first duly sworn on oath, says: That I have knowledge of the facts, statements, and matters herein contained and the log of the above-described well as filed and that the same are true and correct. So help me God.

(Signature) Leslie Kite
Box 486, Great Bend, Kansas 67530 (Address)

SUBSCRIBED AND SWORN TO before me this 14th day of February, 1967

My commission expires April 1, 1967
Ulanda Nichols Notary Public.

DRILLER'S LOG

COMPANY: Mobil Oil Corporation
 CONTRACTOR: LEBEN DRILLING, INC.
 FARM: S. SCHWEIN #1
 LOCATION: C SW SE SEC. 18-20S-21W
 NESS COUNTY, KANSAS
 COMMENCED: 1-30-67
 COMPLETED: 2-9-67

0	524	Surface Soil, Post Rock, Shale
524	811	Shale, Redbed
811	817	Blaine
817	1030	Shale
1030	1090	Sand
1090	1450	Shale
1450	1485	Anhydrite
1485	2250	Shale, Shells
2250	2325	Lime, Shale
2325	2480	Shale, Lime
2480	2935	Lime
2935	3365	Lime, Shale
3365	3590	Lime, Chalky Shale
3590	3740	Lime, Shale
3740	4437	Lime
4437	4500	Lime, Chert
	<u>4500</u>	<u>RTD - D. & A.</u>

RECEIVED
STATE CORPORATION COMMISSION

FEB 15 1967

CONSERVATION DIVISION
Wichita, Kansas

8 5/8" new surface casing set @ 522' cemented with 285 sacks of Common cement, 3% cc

I, Leslie Kite, do hereby certify that the above and foregoing is a true and correct copy of the log of the S. Schwein #1 Well, located C SW SE of Section 18, Township 20 South, Range 21 West, Ness County, Kansas, as reflected by the records of Leben Drilling, Inc.

Leslie Kite

Leslie Kite

STATE OF KANSAS)
) SS
COUNTY OF BARTON)

Subscribed and sworn to and before me, a Notary Public, in and for Barton County, Kansas, this 14th day of February, 1967.

Ulanda Nichols

Ulanda Nichols

My Commission Expires:
April 1, 1967