


STATE OF KANSAS  
STATE CORPORATION COMMISSION

WELL PLUGGING RECORD

Give All Information Completely  
Make Required Affidavit  
Mail or Deliver Report to:  
Conservation Division  
State Corporation Commission  
212 No. Market  
Wichita, Kansas

NORTH

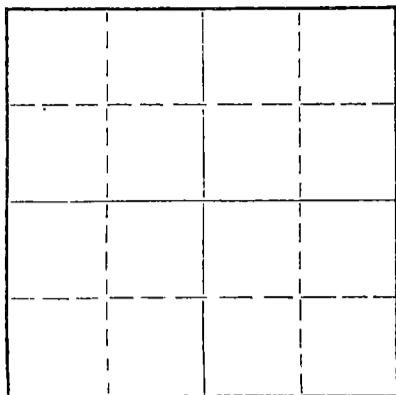

Locate well correctly on above  
Section Plat

Ness County, Sec. 18 Twp. 20S Rge. 21W ~~22E~~ (W)

Location as "NE/CNW/SW" or footage from lines NE NW SE  
Lease Owner Pickrell Drilling Company  
Lease Name Schwein "A" Well No. 1  
Office Address 705 Fourth National Bank Bldg., Wichita, Kansas  
Character of Well (completed as Oil, Gas or Dry Hole) Dry Hole  
Date well completed August 24 1969  
Application for plugging filed August 24 1969  
Application for plugging approved August 24 1969  
Plugging commenced August 24 1969  
Plugging completed August 24 1969  
Reason for abandonment of well or producing formation Dry Hole

If a producing well is abandoned, date of last production 19\_\_\_\_  
Was permission obtained from the Conservation Division or its agents before plugging was commenced? Yes

Name of Conservation Agent who supervised plugging of this well Leo E. Massey  
Producing formation \_\_\_\_\_ Depth to top \_\_\_\_\_ Bottom \_\_\_\_\_ Total Depth of Well 4460 Feet  
Show depth and thickness of all water, oil and gas formations.

OIL, GAS OR WATER RECORDS

CASING RECORD

FORMATION	CONTENT	FROM	TO	SIZE	PUT IN	PULLED OUT
					272'	None

RECEIVED  
STATE CORPORATION COMMISSION  
AUG 29 1969  
CONSERVATION DIVISION  
Wichita, Kansas

Describe in detail the manner in which the well was plugged, indicating where the mud fluid was placed and the method or methods used in introducing it into the hole. If cement or other plugs were used, state the character of same and depth placed, from \_\_\_\_\_ feet to \_\_\_\_\_ feet for each plug set.


Bottom Plug set @ 600' w/70 sacks cement, middle  
plug @ 250' w/20 sacks cement, top plug @ 40' w/10 sacks  
cement.

(If additional description is necessary, use BACK of this sheet)

Name of Plugging Contractor Pickrell Drilling Company  
Address 705 Fourth National Bank Bldg., Wichita, Kansas

STATE OF Kansas, COUNTY OF Sedgwick, ss.  
Dale M. Robinson (employee of owner) or (owner or operator) of the above-described well, being first duly sworn on oath, says: That I have knowledge of the facts, statements, and matters herein contained and the log of the above-described well as filed and that the same are true and correct. So help me God.

(Signature) Dale M. Robinson  
705 Fourth National Bank Bldg., Wichita, Kansas  
(Address)

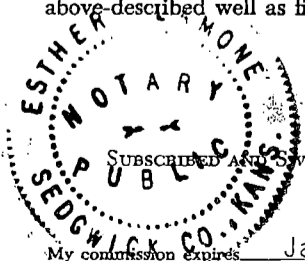

SUBSCRIBED AND SWORN TO before me this 28th day of August, 19 69

Esther Lamone  
Notary Public.

My commission expires Jan. 19, 1973

ROTARY DRILLING LOG

15.135.20280.0000

COMPANY: Pickrell Drilling Company  
705 Fourth National Bank Bldg.  
Wichita, Kansas

Rotary Drilling Commenced 8/15/69

Rotary Drilling Completed 8/24/69

LOCATION: Schwien "A" No. 1, NE NW SE, Section 18-20S-21W  
Ness County, Kansas

CONTRACTOR: **PICKRELL DRILLING COMPANY**  
Wichita, Kansas

CASING RECORD: Ran 11 jts. 28# 8-5/8" Surface Casing set @ 272' K.B. Cemented with 165 Sacks. Completed 2:45 P.M. August 15, 1969. Circulated.

No oil string run. D & A. Plugged August 24, 1969

LOG

(Figures indicate bottom of formation — measurements from top of rotary bushing.)

65	Post Rock	C. F. S.
272	Shale & Shells	4340
883	Shale & Sand	4380
1090	Sand	4390
1200	Shale - Red Bed	4410
1447	Red Beds - Shale	4360
1480	Anhydrite	
1850	Shale - Shells	
2115	Shale w/Lime	S. L. M.
2590	Lime - Shale	
2725	Lime	Board 3917.72
2855	Lime - Shale	Strap 3916.36
3175	Shale & Lime	1.36 Difference
3355	Lime - Shale	
3765	Shale w/Lime	
4325	Lime	Slope Tests
4375	Lime & Shale	
4390	Sand	2000
4405	Lime	2500
4460	Lime & Chert, RTD	3000
		3500
		4000

RECEIVED  
STATE CORPORATION COMMISSION  
AUG 29 1969  
CONSERVATION DIVISION  
Wichita, Kansas

The undersigned, Dale M. Robinson, Attorney-in-Fact for PICKRELL DRILLING COMPANY, hereby certifies in behalf of said Company, that the above is a true and correct log of the formation encountered in drilling the above well as reflected by the Daily Drilling Reports.

PICKRELL DRILLING COMPANY  
By Dale M. Robinson  
Attorney-in-Fact  
Dale M. Robinson

STATE OF KANSAS }  
COUNTY OF SEDGWICK } ss.:

On this 28th day of August, 19 69, before me the undersigned, a Notary Public, in and for the County and State aforesaid, personally appeared Dale M. Robinson, to me known to be the identical person who subscribed the name of PICKRELL DRILLING COMPANY to the foregoing instrument as its Attorney-in-Fact and acknowledged to me that he executed the same as his free and voluntary act and deed, and as the free and voluntary act and deed of such company, for the uses and purposes therein set forth.

Given under my hand and seal of office the day and year last above written.

My commission expires: Jan. 19, 1973

Esther Lamone  
Notary Public  
Esther Lamone

