


WELL PLUGGING RECORD

Give All Information Completely
Make Required Affidavit
Mail or Deliver Report to:
Conservation Division
State Corporation Commission
800 Bittling Building
Wichita, Kansas

Ness County. Sec. 18 Twp. 20 Rge. 21 (E) W (W)

Location as "NE/CNW $\frac{1}{4}$ SW $\frac{1}{4}$ " or footage from lines SW SW SW
Lease Owner B & R Drilling, Inc.
Lease Name Schwein Well No. 1
Office Address Russell, Kansas
Character of Well (completed as Oil, Gas or Dry Hole) Dry Hole
Date well completed 1-12-52 19
Application for plugging filed 1-11-52 19
Application for plugging approved 1-11-52 19
Plugging commenced 1-12-5-2 19
Plugging completed 1-12-52 19
Reason for abandonment of well or producing formation Dry Hole

NORTH

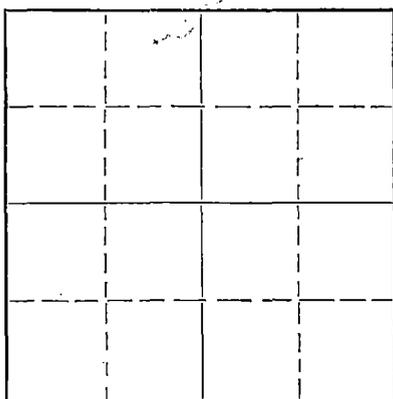

Locate well correctly on above Section Plat

If a producing well is abandoned, date of last production 19
Was permission obtained from the Conservation Division or its agents before plugging was commenced? Yes

Name of Conservation Agent who supervised plugging of this well
Producing formation Depth to top Bottom Total Depth of Well 4515 Feet
Show depth and thickness of all water, oil and gas formations.

OIL, GAS OR WATER RECORDS

CASING RECORD

Formation	Content	From	To	Size	Put In	Pulled Out
				8 5/8"	240	None

Describe in detail the manner in which the well was plugged, indicating where the mud fluid was placed and the method or methods used in introducing it into the hole. If cement or other plugs were used, state the character of same and depth placed, from feet to feet for each plug set.

Plugging Record

Circulate 2 hours waiting on orders. Layed down drill pipe. Filled hole with mud to 225'. Set first wooden plug 225'. Cemented 15 sacks cement. Filled hole to 40' with mud. Set second wooden plug 40' with wire. 1/2 sacks hulls 10 sacks cement

(If additional description is necessary, use BACK of this sheet)

Name of Plugging Contractor
Address

STATE OF KANSAS, COUNTY OF RUSSELL, ss.
W. A. Michaelis, Jr. (employee of owner) or (owner or operator) of the above-described well, being first duly sworn on oath, says: That I have knowledge of the facts, statements, and matters herein contained and the log of the above-described well as filed and that the same are true and correct. So help me God.

(Signature) W. A. Michaelis, Jr.

Russell, Kansas (Address)

SUBSCRIBED AND SWORN to before me this 22nd day of January, 19 52

My commission expires 6-17-54. 23-8390-s

Notary Public. (Signature)

PLUGGING
FILE SEC 18 T 20 R 21W
BOOK PAGE 137 LINE 26

RECEIVED
JAN 23 1952 1-23-52
CONSERVATION DIVISION
Wichita, Kansas

B & R Drilling, Inc.
Schwein #1

SW SW SW Sec. 18-20-21
Ness County, Kansas

Total Depth: 4515
Comm. 12/17/51
Comp. 1/12/52

Casing

8 5/8" Set @ 240

Cement

175 sacks Lehigh

Formation	Depth
Sand-shale-lime	150
Shale	220
Red bed	240
Shale-red bed	350
Sand	445
Red bed-shale-shells	680
Red bed-shale	700
Red Bed	800
Shale-red bed	860
Sand	1090
Red bed-shale	1180
Red bed-shale-shells	1412
Lime-anhydrite-red bed	1445
Anhydrite-red bed	1450
Shale-shells-red bed	1690
Shale-shells	1770
Shale	1805
Shale-shells-red bed	2120
Shale-shells	2215
Shale-lime	2255
Lime	2300
Lime-shale	2675
Shale	2685
Lime-shale	2820
Lime	2880
Lime-shale	3795
Lime	4055
Lime-shale	4353
Shale-lime-chert	4370
Shale-chert	4390
Lime-chert	4459
Chert	4466
Chert-lime-shale	4475
Lime-shale	4515

STATE OF KANSAS)
) ss
RUSSELL COUNTY)

I hereby certify that the above information is true and correct to the best of my knowledge.

-----*Pora Betty*-----

Subscribed and sworn to before me this 22nd day of January, 1952.

-----*Clara Samuel*-----
Notary Public

My commission expires: 6-17-54.

RECEIVED
STATE COMMISSIONER

JAN 23 1952

PLUGGING
FILE SEC 18-20-21
BOOK PAGE 137 LINE 46