

STATE OF KANSAS
STATE CORPORATION COMMISSION

Form CP-4


Give All Information Completely
Make Required Affidavit
Mail or Deliver Report to:
Conservation Division
State Corporation Commission
212 No. Market
Wichita, Kansas

WELL PLUGGING RECORD

Ness County, Sec. 18 Twp. 20S Rge. 21W (E) (W)

Location as "NE/CNW/SW" or footage from lines NE SW SW
Lease Owner Brandt-Clark Oil Co.
Lease Name Schwein Well No. 2
Office Address 505 1st Natl. Bank Bldg., Wichita, Kansas 67202
Character of Well (completed as Oil, Gas or Dry Hole) Dry Hole
Date well completed June 20 19 69
Application for plugging filed June 20 19 69
Application for plugging approved June 20 19 69
Plugging commenced June 20 19 69
Plugging completed June 20 19 69
Reason for abandonment of well or producing formation Dry Hole

NORTH

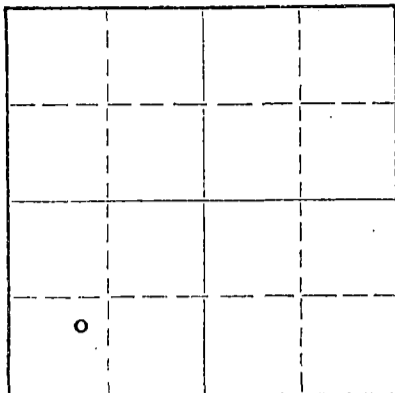

Locate well correctly on above Section Plat

If a producing well is abandoned, date of last production 19
Was permission obtained from the Conservation Division or its agents before plugging was commenced? Yes

Name of Conservation Agent who supervised plugging of this well Donald Truan, Box 148, Russell, Kansas 67665

Producing formation _____ Depth to top _____ Bottom _____ Total Depth of Well 4386 Feet

Show depth and thickness of all water, oil and gas formations.

OIL, GAS OR WATER RECORDS

CASING RECORD

FORMATION	CONTENT	FROM	TO	SIZE	PUT IN	PULLED OUT
		0	462'	8 5/8"	462'	None

Describe in detail the manner in which the well was plugged, indicating where the mud fluid was placed and the method or methods used in introducing it into the hole. If cement or other plugs were used, state the character of same and depth placed, from _____ feet to _____ feet for each plug set.

Plug: 450'/30 sacks cement/1/4 sack hulls
40'/10 sacks cement/1/4 sack hulls
2 sacks cement in rat hole

RECEIVED
STATE CORPORATION COMMISSION
JUL 1 1969
CONSERVATION DIVISION
Wichita, Kansas

(If additional description is necessary, use BACK of this sheet)

Name of Plugging Contractor Hellar Drilling Company, Inc.
Address 339 Union Center Bldg., Wichita, Kansas 67202

STATE OF Kansas, COUNTY OF Sedgwick, ss.

D. L. Hellar, Pres. of Hellar Drilling Company, Inc. (employee of owner) or (owner or operator) of the above-described well, being first duly sworn on oath, says: That I have knowledge of the facts, statements, and matters herein contained and the log of the above-described well as filed and that the same are true and correct. So help me God.

(Signature) *D. L. Hellar* D. L. Hellar, President
339 Union Center Bldg., Wichita, Kansas 67202
(Address)

SUBSCRIBED AND SWORN to before me this 30th day of June, 19 69
My commission expires March 25, 1972



Catherine Darcey
Catherine Darcey - Notary Public.

DRILLER'S LOG

COMPANY: Brandt-Clark Oil Co., Wichita, Kansas
 CONTRACTOR: Hellar Drilling Co. Inc., Wichita, Kansas
 LEASE: #2 Schwein
 LOCATION: NE SW SW 18-20S-21W, Ness County, Kansas
 COMMENCED: June 10, 1969
 COMPLETED: June 20, 1969
 CASING: Set 8 5/8" Surface Casing @ 462'/275 sacks cement

0-462	Post Rock, Shale & Sand
462-1421	Shale & Shells
1421-1455	Anhydrite
1455-2265	Salt Section
2265-2548	Lime & Shale - Ft. Riley
2548-3540	Lime & Shale
3540-3588	Lime
3588-3740	Lime & Shale
3740-3860	Lime - K. C. Lime
3860-4127	Lime & Shale - K. C. Lime
4127-4208	Lime & Shale
4208-4360	Lime
4360-4366	Chert
4366-4386	Miss. Chert
4386	Rotary Total Depth

D & A

RECEIVED
 STATE CORPORATION COMMISSION

JUL 1 1969
 CONSERVATION DIVISION
 Wichita, Kansas

STATE OF KANSAS)
) SS
 COUNTY OF SEDGWICK)

I, D. L. Hellar, do hereby certify that the above and foregoing is a true and correct copy of the log of the #2 Schwein, located in NE SW SW 18-20S-21W, Ness County, Kansas, as reflected by the files of the Hellar Drilling Company, Inc.

HELLAR DRILLING COMPANY, INC.

By *D. L. Hellar*
 President - D. L. Hellar

Subscribed and sworn to before me, a Notary Public, in and for Sedgwick County, Kansas, this 30th day of June, 1969.

Catherine Darcey
 Notary Public - Catherine Darcey

My Commission Expires: March 25, 1972.

