

Give All Information Completely
Make Required Affidavit
Mail or Deliver Report to:
Conservation Division
State Corporation Commission
212 No. Market
Wichita, Kansas

WELL PLUGGING RECORD

Ness County, Sec. 11 Twp. 20S Rge. 21W (W)

Location as "NE/CNW/SW" or footage from lines C SE NW

Lease Owner D. R. Lauck Oil Company, Inc.

Lease Name Shank Well No. 1

Office Address 301 S. Broadway, Wichita, Kansas

Character of Well (completed as Oil, Gas or Dry Hole) Dry Hole

Date well completed September 3, 1967

Application for plugging filed September 3, 1967

Application for plugging approved September 3, 1967


Plugging commenced September 3, 1967

Plugging completed September 3, 1967

Reason for abandonment of well or producing formation Dry Hole

If a producing well is abandoned, date of last production _____ 19____

Was permission obtained from the Conservation Division or its agents before plugging was commenced? Yes

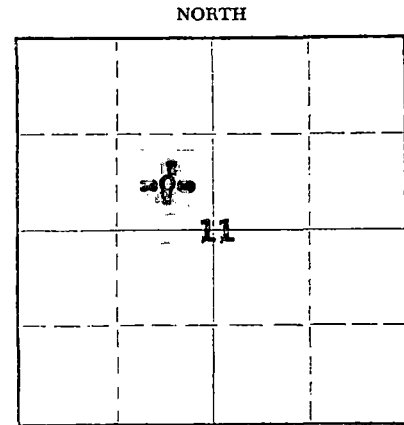

Locate well correctly on above
Section Plat

Name of Conservation Agent who supervised plugging of this well Leo Massey

Producing formation _____ Depth to top _____ Bottom _____ Total Depth of Well 4525 Feet

Show depth and thickness of all water, oil and gas formations.

OIL, GAS OR WATER RECORDS

CASING RECORD

FORMATION	CONTENT	FROM	TO	SIZE	PUT IN	PULLED OUT
		0'	393'	8-5/8"	393'	None

RECEIVED
STATE CORPORATION COMMISSION
SEP 18 1967
WICHITA, KANSAS

Describe in detail the manner in which the well was plugged, indicating where the mud fluid was placed and the method or methods used in introducing it into the hole. If cement or other plugs were used, state the character of same and depth placed from _____ feet to _____ feet for each plug set.

4525' to 620' Mud
 620' to 616' Plug
 616' to 576' Cement, 65 sacks
 576' to 40' Mud
 40' to 36' Plug & bridge
 36' to 6' Cement, 10 sacks (Bottom of cellar)

(If additional description is necessary, use BACK of this sheet)

Name of Plugging Contractor Globe Cementing Co.
Address Great Bend, Kansas

STATE OF KANSAS, COUNTY OF SEDGWICK, ss.
John H. Knightley (employee of owner) or (owner or operator) of the above-described

well, being first duly sworn on oath, says: That I have knowledge of the facts, statements, and matters herein contained and the log of the above-described well as filed and that the same are true and correct. So help me God.

(Signature) John H. Knightley
301 S. Broadway, Wichita, Kansas
(Address)

SUBSCRIBED AND SWORN TO before me this 15th day of September, 1967

My commission expires March 12, 1971

Stella J. Lippa
Notary Public.

D. R. Lauck Oil Company, Inc.

Shank #1

C SE NW Sec. 11-20S-21W
Ness County, Kansas

Commenced: 8/22/67

Completed: 9/3/67

Casing Record: 393' 8-5/8" Cemented with 220 sacks Cement,
4 sacks Calcium Chloride.

Elevation: GL 2251; DF 2254; KB 2256.

Drillers Log

Tops

Drillers Log		Tops	
		Samples	Schlumberger
Surface Clay	40		
Shale	279	Anhydrite	1459+795 1460+796
Sand	285	Heebner	3787-1531 3788-1532
Shale	310	Toronto	3803-1547 3804-1548
Sand	330	Lansing	3834-1578 3834-1578
Shale & Red Bed	394	Base Kansas City	4159-1903 4160-1904
Shale, Shells & Sand		Pawnee	4242-1986 4244-1988
Streaks	555	Fort Scott	4335-2079 4337-2081
Shale	640	Cherokee	4353-2097 4356-2100
Red Bed	900	Cherty Conglomerate	4404-2148 4410-2154
Sand	1095	Mississippian	
Red Bed	1459	(Warsaw?)	4416-2160 4419-2163
Anhydrite	1500	Osage	4435-2179 4439-2183
Shale & Shells	2250	Total Depth	4525-2269 4527-2271
Lime & Shale	3840		
Lime	4315		
Lime & Shale	4380	DST - None.	
Lime & Chert	4414		
Lime, Shale, Chert	4445		
Chert	4503		
Chert & Lime	4525 RTD		D&A

RECEIVED
STATE CORPORATION COMMISSION

SEP 18 1967

CONSERVATION DIVISION
Wichita, Kansas