

STATE OF KANSAS
STATE CORPORATION COMMISSION


Form CP-4

WELL PLUGGING RECORD

Give All Information Completely
Make Required Affidavit
Mail or Deliver Report to:
Conservation Division
State Corporation Commission
212 No. Market
Wichita, Kansas

Ness County. Sec. 10 Twp. 20S Rge. (E) 21(W)

Location as "NE/CNW/SW" or footage from lines C SE NW
Lease Owner Brandt-Clark Oil Company
Lease Name Kramer Well No. 1
Office Address 737 First Ntl Bank Bldg. Wichita, Kansas
Character of Well (completed as Oil, Gas or Dry Hole) Dry Hole
Date well completed 10-17 1968
Application for plugging filed 10-17 1968
Application for plugging approved 10-17 1968
Plugging commenced 10-17 1968
Plugging completed 10-17 1968
Reason for abandonment of well or producing formation Dry Hole

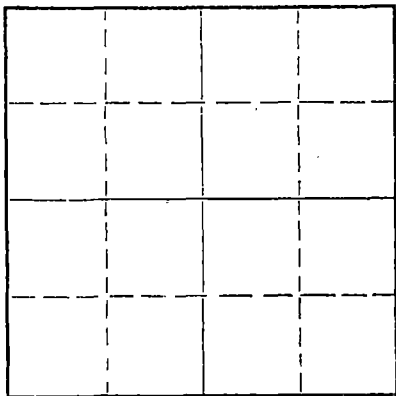

Locate well correctly on above Section Plat

If a producing well is abandoned, date of last production _____ 19____
Was permission obtained from the Conservation Division or its agents before plugging was commenced? Yes

Name of Conservation Agent who supervised plugging of this well Leo Massey
Producing formation _____ Depth to top _____ Bottom _____ Total Depth of Well 4462 Feet
Show depth and thickness of all water, oil and gas formations.

OIL, GAS OR WATER RECORDS

CASING RECORD

FORMATION	CONTENT	FROM	TO	SIZE	PUT IN	PULLED OUT
				8 5/8"	532	none

Describe in detail the manner in which the well was plugged, indicating where the mud fluid was placed and the method or methods used in introducing it into the hole. If cement or other plugs were used, state the character of same and depth placed, from _____ feet to _____ feet for each plug set.

Plugged with 50 sacks Posmix 6% gel set @ 720'
Plugged with 25 sacks Posmix 6% gel @ 480'
Plugged with 1/2 sacks hulls 10 sacks cement @ 40'

RECEIVED
STATE CORPORATION COMMISSION
OCT 23 1968
CONSERVATION DIVISION
Wichita, Kansas

(If additional description is necessary, use BACK of this sheet)

Name of Plugging Contractor Leben Drilling, Inc.
Address Box 486, Great Bend, Kansas

STATE OF KANSAS, COUNTY OF BARTON, ss.
Leslie Kite (employee of owner) or (owner or operator) of the above-described well, being first duly sworn on oath, says: That I have knowledge of the facts, statements, and matters herein contained and the log of the above-described well as filed and that the same are true and correct. So help me God.

(Signature) Leslie Kite

(Address)

SUBSCRIBED AND SWORN to before me this 21st day of October, 1968

My commission expires April 1, 1971

Ulanda Nichols
Notary Public.

DRILLER'S LOG

COMPANY	Brandt-Clark Oil Company
CONTRACTOR	LEBEN DRILLING, INC.
FARM	KRAMER #1
LOCATION	C SE NW SECTION 10-20S-21W NESS COUNTY, KANSAS
COMMENCED	10-8-68
COMPLETED	10-17-68

0	40	Clay
40	532	Shale, Sand, Shale
532	610	Shale
610	1455	Shale, Sand, Shale
1455	1488	Anhydrite
1488	2240	Shale, Shells
2240	2435	Shale, Lime
2435	4440	Lime
4440	4462	Chert
	<u>4462</u>	<u>RTD - D. & A.</u>

RECEIVED
STATE CORPORATION COMMISSION
OCT 23 1968
CONSERVATION DIVISION
Wichita, Kansas

surface
8 5/8" 20# new/casing set @ 532' with 200 sacks Common cement, 2%
cc

I, Leslie Kite, do hereby certify that the above and foregoing is a true and correct copy of the log of the Kramer #1 Well, located C SE NW of Section 10, Township 20 South, Range 21 West, Ness County, Kansas, as reflected by the records of Leben Drilling, Inc.

Leslie Kite
Leslie Kite

STATE OF KANSAS)
) SS
COUNTY OF BARTON)

Subscribed and sworn to and before me, a Notary Public, in and for Barton County, Kansas, this 21st day of October, 1968.

Ulanda Nichols
Ulanda Nichols

My Commission Expires:
April 1, 1971