

Give All Information Completely
Make Required Affidavit
Mail or Deliver Report to:
Conservation Division
State Corporation Commission
211 No. Broadway
Wichita, Kansas

WELL PLUGGING RECORD

Ness County, Sec. 30 Twp. 20 Rge. 21 ~~22~~ (W)

Location as "NE/CNW*SW*" or footage from lines C NW/4 SE/4

Lease Owner Colorado Oil & Gas Corporation

Lease Name Wittman Well No. 1

Office Address Box 1030, Wichita, Kansas

Character of Well (completed as Oil, Gas or Dry Hole) Dry Hole

Date well completed June 30 1961

Application for plugging filed June 30 1961

Application for plugging approved June 30 1961


Plugging commenced June 30 1961

Plugging completed June 30 1961

Reason for abandonment of well or producing formation _____

If a producing well is abandoned, date of last production _____ 19____

Was permission obtained from the Conservation Division or its agents before plugging was commenced? Yes

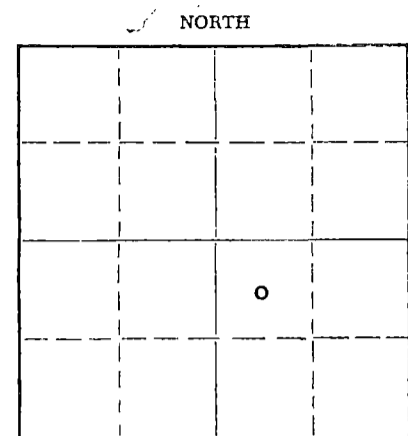

Locate well correctly on above Section Plat

Name of Conservation Agent who supervised plugging of this well Eldon Petty

Producing formation _____ Depth to top _____ Bottom _____ Total Depth of Well 4415 Feet

Show depth and thickness of all water, oil and gas formations.

OIL, GAS OR WATER RECORDS

CASING RECORD

FORMATION	CONTENT	FRDM	TD	SIZE	PUT IN	PULLED OUT
				8-5/8"	316'	None

Describe in detail the manner in which the well was plugged, indicating where the mud fluid was placed and the method or methods used in introducing it into the hole. If cement or other plugs were used, state the character of same and depth placed, from _____ feet to _____ feet for each plug set.

Plugged at 600' with 1/2 sack hulls, 2nd. 20 sacks cement.

Plugged at 200' with 1/2 sack hulls, 2nd. 20 sacks cement.

Plugged at 40' with 1/2 sack hulls, and 10 sacks cement.

RECEIVED
STATE CORPORATION COMMISSION

JUL 10 1961

CONSERVATION DIVISION
Wichita, Kansas

(If additional description is necessary, use BACK of this sheet)

Name of Plugging Contractor Strata Drilling, Inc.

Address 2421 Tenth St., Great Bend, Kansas

STATE OF Kansas, COUNTY OF Sedgwick, ss.

B. K. Henrichs (employee of owner) or (~~owner~~) of the above-described

well, being first duly sworn on oath, says: That I have knowledge of the facts, statements, and matters herein contained and the log of the above-described well as filed and that the same are true and correct. So help me God.

(Signature) B. K. Henrichs

B. K. Henrichs

Box 1030, Wichita, Kansas

(Address)

SUBSCRIBED AND SWORN TO before me this 7 day of July, 19 61

Helen L. Martin
Helen L. Martin Notary Public.

My commission expires August 19, 1963



D R I L L E R S L O G

#1 Wittman

CASING RECORD: 315.87' of new 8-5/8" surface casing.
 COMPANY: Colorado Oil and Gas Corporation
 DESCRIPTION: C/NW SE Section 30-20-21W Ness County, Kansas
 CONTRACTOR: Strata Drilling, Inc.
 TOTAL DEPTH: 4415'
 COMMENCED: June 19, 1961
 COMPLETED: June 30, 1961

D. & A.

FORMATION	FROM	TO	REMARKS
Surface Soil	0	230	Ran 315.87' of new 8-5/8" surface casing; set and cemented at 323.37' with 225 sacks of cement, 2% gel and 2% C. C. Plug down at 8:00 P. M. June 19, 1961.
Shale	230	725	
Red Bed	725	812	
Sand	812	1012	
Shale & Shells	1012	1370	
Anhydrite	1370	1407	
Shale	1407	1570	
Shale & Lime	1570	2340	
Shale	2340	2485	
Lime	2485	2685	
Lime & Shale	2685	3858	
Lime	3858	3918	
Lime & Shale	3918	4130	
Lime	4130	4265	
Lime & Shale	4265	4288	
Lime & Chert	4288	4333	
Chert	4333	4355	
Chert Lime	4355	4415	

RECEIVED
STATE CORPORATION COMMISSION

JUL 10 1961

CONSERVATION DIVISION
Topeka, Kansas

Total Depth 4415'

D. & A.

Plugged at 600' with $\frac{1}{2}$ sack of hulls and 20 sacks of cement; plugged at 200' with $\frac{1}{2}$ sack of hulls and 20 sacks of cement; plugged at 40' with $\frac{1}{2}$ sack of hulls and 10 sacks of cement. Plug down at 5:15 A. M. June 30, 1961.

STATE OF KANSAS)
) ss.
 COUNTY OF BARTON)

I certify that this is a true and correct copy of the above log to the best of my knowledge.

STRATA DRILLING, INC.

Charles W. Steincamp
Charles W. Steincamp, President

Subscribed and sworn to before me this 3rd day of July, 1961.

Elaine H. Taylor
Elaine H. Taylor, Notary Public

My Commission Expires:

December 14, 1961