


STATE OF KANSAS  
STATE CORPORATION COMMISSION

Form CP-4

Give All Information Completely  
Make Required Affidavits  
Mail or Deliver Report to:  
Conservation Division  
State Corporation Commission  
212 No. Market  
Wichita, Kansas

WELL PLUGGING RECORD

NORTH

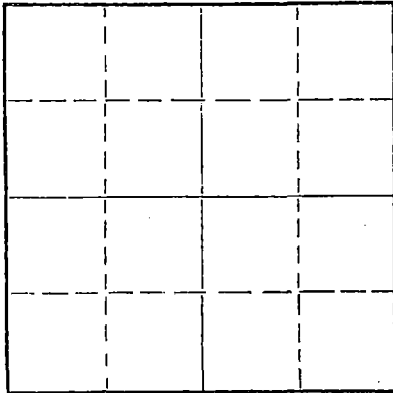

Locate well correctly on above  
Section Plat

Ness County, Sec. 26 Twp. 20S Rge. (E) 21 (W)  
Location as "NE/CNW $\frac{1}{4}$ SW $\frac{1}{4}$ " or footage from lines 125' south of C NW NE  
Lease Owner O. A. Sutton  
Lease Name Lewis Well No. 2  
Office Address 407 Insurance Building, Wichita, Kansas  
Character of Well (completed as Oil, Gas or Dry Hole) Dry Hole  
Date well completed June 29 1966  
Application for plugging filed June 29 1966  
Application for plugging approved June 29 1966  
Plugging commenced June 29 1966  
Plugging completed June 29 1966  
Reason for abandonment of well or producing formation \_\_\_\_\_

If a producing well is abandoned, date of last production \_\_\_\_\_ 19\_\_\_\_  
Was permission obtained from the Conservation Division or its agents before plugging was commenced? Yes

Name of Conservation Agent who supervised plugging of this well Leo Massey  
Producing formation \_\_\_\_\_ Depth to top \_\_\_\_\_ Bottom \_\_\_\_\_ Total Depth of Well 4477 Feet  
Show depth and thickness of all water, oil and gas formations.

OIL, GAS OR WATER RECORDS

CASING RECORD

FORMATION	CONTENT	FROM	TO	SIZE	PUT IN	PULLED OUT
				8-5/8"	350	

Describe in detail the manner in which the well was plugged, indicating where the mud fluid was placed and the method or methods used in introducing it into the hole. If cement or other plugs were used, state the character of same and depth placed, from \_\_\_\_\_ feet to \_\_\_\_\_ feet for each plug set.

#1 plug set at 540' with 25 sacks cement;  
#2 plug set at 350' with 20 sacks cement;  
#3 plug set at 40' with 10 sacks cement;  
5 sacks cement in rat hole. Job complete  
at 10:30 a. m. 6-29-66.

RECEIVED  
STATE CORPORATION COMMISSION

JUL 7 1966

CONSERVATION DIVISION  
Wichita, Kansas

(If additional description is necessary, use BACK of this sheet)

Name of Plugging Contractor Hellar Drilling Co., Inc.  
Address 1014 Union Center, Wichita, Kansas

STATE OF KANSAS, COUNTY OF SEDGWICK, ss.  
Jack G. Paulsen (employee of owner) or ~~(owner or operator)~~ of the above-described well, being first duly sworn on oath, says: That I have knowledge of the facts, statements, and matters herein contained and the log of the above-described well as filed and that the same are true and correct. So help me God.

(Signature) Jack G. Paulsen  
Jack G. Paulsen  
407 Insurance Building, Wichita, Kansas  
(Address)

SUBSCRIBED AND SWORN TO before me this 5th day of July, 1966

My commission expires June 17, 1969

Patricia K. Collins  
Patricia K. Collins  
Notary Public.

DRILLER'S LOG

COMPANY: O. A. Sutton, 407 Insurance Bldg., Wichita, Kansas  
 CONTRACTOR: Hellar Drilling Company, Inc., Wichita, Kansas  
 LEASE: #2 Lewis  
 LOCATION: 125' South of C NW NE Sec. 26-20S-21W, Ness County, Ks.  
 COMMENCED: June 18, 1966  
 COMPLETED: June 29, 1966  
 CASING: Set 8 5/8" surface casing @ 350'/250 sacks cement

0-350	Surface sand & soil
350-1398	Shale, shell, sand & Red Bed
1398-1428	Anhydrite
1428-1884	Shale, Red Bed & shells
1884-2408	Salt Section
2408-2575	Ft. Riley cherty lime
2575-2854	Lime & shale
2854-3552	Shale & lime
3552-3811	Lime & shale
3811-3930	Lsg. K.C.
3930-4073	Lime
4073-4315	Lime & shale
4315-4359	Lime, shale & cherty lime
4359-4369	Cherty Cong.
4369-4474	Miss. chert
4474-4477	Lime
4477	Rotary Total Depth

RECEIVED  
 STATE CORPORATION COMMISSION  
 JUL 6 1966  
 CONSERVATION DIVISION  
 Wichita, Kansas

D & A

STATE OF KANSAS        )  
                               ) SS  
 COUNTY OF SEDGWICK )

I, D. L. Hellar, do hereby certify that the above and foregoing is a true and correct copy of the log of the #2 Lewis, located 125' South of C NW NE Sec. 26-20S-21W, Ness County, Kansas, as reflected by the files of the Hellar Drilling Company, Inc.

HELLAR DRILLING COMPANY, INC.

By *D. L. Hellar*  
 President - D. L. Hellar

Subscribed and sworn to before me, a Notary Public, in and for Sedgwick County, Kansas, this 5th day of July, 1966.

My Commission Expires:

*Catherine Darcey*  
 Notary Public - Catherine Darcey

March 25, 1968.