


Give All Information Completely
Make Required Affidavit
Mail or Deliver Report to:
Conservation Division
State Corporation Commission
211 No. Broadway
Wichita, Kansas

WELL PLUGGING RECORD

Ness County. Sec. 26 Twp. 20 Rge. 21W (E) (W)

Location as "NE/CNW%SW%" or footage from lines 150' NE of C NE SE
Lease Owner DONALD C. SLAWSON
Lease Name Lewis 'B' Well No. 2
Office Address 408 One Twenty Building - Wichita, Kansas
Character of Well (completed as Oil, Gas or Dry Hole) Dry Hole
Date well completed September 8, 19 66
Application for plugging filed " 8, 19 66
Application for plugging approved " 8, 19 66
Plugging commenced " 8, 19 66
Plugging completed " 8, 19 66
Reason for abandonment of well or producing formation Dry Hole

NORTH

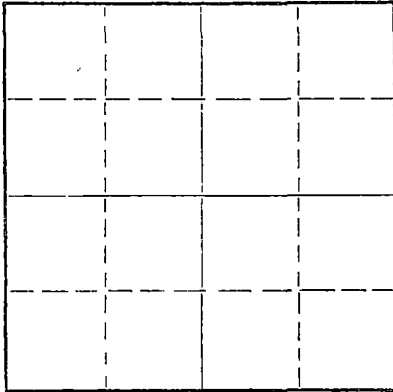

Locate well correctly on above
Section Plat

If a producing well is abandoned, date of last production _____ 19 ____
Was permission obtained from the Conservation Division or its agents before plugging was commenced? Yes

Name of Conservation Agent who supervised plugging of this well Leo Massey - Box 582 - Hays, Kansas
Producing formation _____ Depth to top _____ Bottom _____ Total Depth of Well 4405 Feet
Show depth and thickness of all water, oil and gas formations.

OIL, GAS OR WATER RECORDS

CASING RECORD

FORMATION	CONTENT	FROM	TO	SIZE	PUT IN	PULLED OUT

Describe in detail the manner in which the well was plugged, indicating where the mud fluid was placed and the method or methods used in introducing it into the hole. If cement or other plugs were used, state the character of same and depth placed, from _____ feet to _____ feet for each plug set.

Mud to 540', set plug, 30 sx cement
Mud to 275', set plug, 20 sx cement
Set solid bridge at 40', cemented with 10 sx

RECEIVED
STATE CORPORATION COMMISSION
SEP 16 1966
CONSERVATION DIVISION
WELL PLUGGING

(If additional description is necessary, use BACK of this sheet)
Name of Plugging Contractor Slawson Drilling Company, Inc.
Address 408 One Twenty Building - Wichita, Kansas 67202

STATE OF KANSAS, COUNTY OF SEDGWICK, ss.
DONALD C. SLAWSON (employee of owner) or (owner or operator) of the above-described well, being first duly sworn on oath, says: That I have knowledge of the facts, statements, and matters herein contained and the log of the above-described well as filed and that the same are true and correct. So help me God.

(Signature) _____
408 One Twenty Bldg. - Wichita, Kansas
(Address)

SUBSCRIBED AND SWORN TO before me this 15th day of September, 19 66

My commission expires August 25, 1968
Ella Priess Notary Public.

WELL LOG

Company: Donald C. Slawson
 408 One Twenty Building
 Wichita, Kansas 67202

Farm: Lewis 'B' #2
 150' NE of C NE SE of Section 26-20-21W
 Ness County, Kansas

Total Depth: 4405' Elevation: 2228

Commenced: September 1, 1966

Completed: September 9, 1966

Contractor: Slawson Drilling Company, Inc.

Casing: 8 5/8" at 278' with 225 sx cement

0-38	Surface Clay
38-1423	Shale & Shells
1423-1839	Shale & Sand
1839-1921	Salt
1921-2125	Salt, Shale, & Shells
2125-3060	Lime & Shale
3060-3290	Shale & Lime
3290-3432	Lime & Shale
3432-3639	Shale & Lime
3639-4121	Lime
4121-4370	Lime & Shale
4370-4405	Shale & Lime
4405	Total Depth


RECEIVED
 STATE CORPORATION COMMISSION
 SEP 16 1966
 CONSERVATION DIVISION
 WICHITA, KANSAS

STATE OF KANSAS)
) SS:
 COUNTY OF SEDGWICK)

I, Donald C. Slawson, of the Slawson Drilling Company, Inc., upon oath state that the above and foregoing is a true and correct copy of the log of the Lewis 'B' #2 well.


 DONALD C. SLAWSON

Subscribed and sworn to before me this 15th day of September, 1966.

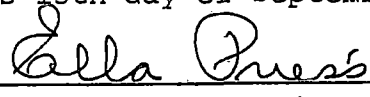
 Ella Priess, Notary Public

My Commission Expires:
 August 25, 1968