

TIGHT HOLE!!!!

CONFIDENTIAL

CONFIDENTIAL

SIDE ONE

STATE CORPORATION COMMISSION OF KANSAS
OIL & GAS CONSERVATION DIVISION
WELL COMPLETION FORM
ACO-1 WELL HISTORY
DESCRIPTION OF WELL AND LEASE

API NO. 15- 135-23,471

County Ness

SW NE Sec. 10 Twp. 20S Rge. 23 East West
3300 Ft. North from Southeast Corner of Section

1980 Ft. West from Southeast Corner of Section
(NOTE: Locate well in section plat below.)


Lease Name McCraith Well # 1

Field Name W.C.

Producing Formation Fort Scott

Elevation: Ground 2257 KB 2262

Total Depth 4450 PBTD

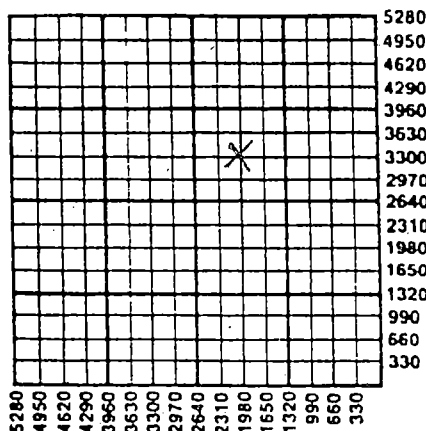

X-23-90

Amount of Surface Pipe Set and Cemented at 510.38 Feet

Multiple Stage Cementing Collar Used? Yes No

If yes, show depth set. 1529' Feet

If Alternate II completion, cement circulated from 1529'-Surface
feet-depth to surface w/ 350 sx cmt.

Operator: License # 6040

Name: Bankoff Oil Company

Address 100 S. Market, #203A

City/State/Zip Wichita, KS 67202

Purchaser: Border Fuel Supply Corp

Operator Contact Person: Frank Mize

Phone (316) 262-2784

Contractor: Name: Abercrombie Drilling, Inc.

License: 5422

Wellsite Geologist: Frank S. Mize

Designate Type of Completion

- New Well Re-Entry Workover
- Oil SWD Temp. Abd.
- Gas Inj Delayed Comp.
- Dry Other (Core, Water Supply, etc.)

If OWNED: old well info as follows:

Operator: _____

Well Name: _____

Comp. Date _____ Old Total Depth _____

Drilling Method:

- Mud Rotary Air Rotary Cable

7-6-90 7-14-90 8-1-90

Spud Date Date Reached TD Completion Date


INSTRUCTIONS: This form shall be completed in triplicate and filed with the Kansas Corporation Commission, 200 Colorado Derby Building, Wichita, Kansas 67202, within 120 days of the spud date of any well. Rule 82-3-130, 82-3-107 and 82-3-106 apply. Information on side two of this form will be held confidential for a period of 12 months if requested in writing and submitted with the form. See rule 82-3-107 for confidentiality in excess of 12 months. One copy of all wireline logs and drillers time log shall be attached with this form. ALL CEMENTING TICKETS MUST BE ATTACHED. Submit CP-4 form with all plugged wells. Submit CP-111 form with all temporarily abandoned wells. Any recompletion, workover or conversion of a well requires filing of ACO-2 within 120 days from commencement date of such work.

All requirements of the statutes, rules and regulations promulgated to regulate the oil and gas industry have been fully complied with and the statements herein are complete and correct to the best of my knowledge.

Signature Frank S. Mize
Exploration Manager Date 8-20-90

Subscribed and sworn to before me this 20 day of August RECEIVED
Notary Public James B. Branstetter
Date Commission Expires April 13, 1993 8-23-90

K.C.C. OFFICE USE ONLY
 Letter of Confidentiality Attached
 Wireline Log Received
 Drillers TimeLog Received
Distribution
 KCC SWD/Rep NGPA
 KGS Plug Other (Specify)

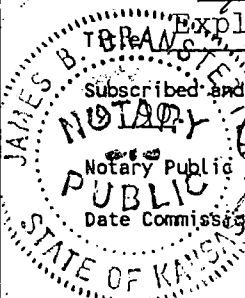

CONSERVATION DIVISION
Wichita, Kansas

P1