

Give All Information Completely
Make Required Affidavit
Mail or Deliver Report to:
Conservation Division
State Corporation Commission
211 No. Broadway
Wichita, Kansas

WELL PLUGGING RECORD

Ness County. Sec. 13 Twp. 20S Rge. 24W (E) (W)
Location as "NE/CNW/SW" or footage from lines. SW SW

Lease Owner R. V. Lehner

Lease Name Rollins Well No. 1

Office Address Ness City, Kansas

Character of Well (completed as Oil, Gas or Dry Hole) Dry Hole

Date well completed January 23 1965

Application for plugging filed January 24 1965

Application for plugging approved January 24 1965


Plugging commenced 7:00 a.m. January 24 1965

Plugging completed 8:45 a.m. January 24 1965

Reason for abandonment of well or producing formation Dry Hole

If a producing well is abandoned, date of last production _____ 19____

Was permission obtained from the Conservation Division or its agents before plugging was commenced? Yes

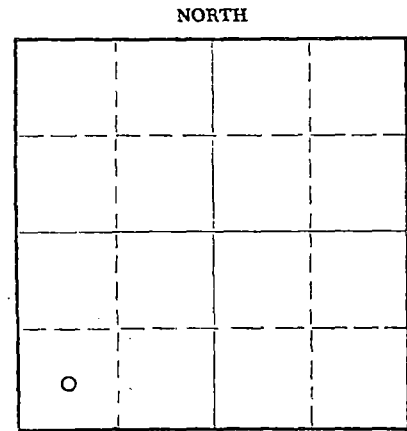

Locate well correctly on above Section Plat

Name of Conservation Agent who supervised plugging of this well Eldon Petty

Producing formation _____ Depth to top _____ Bottom _____ Total Depth of Well _____ Feet

Show depth and thickness of all water, oil and gas formations.

OIL, GAS OR WATER RECORDS

CASING RECORD

FORMATION	CONTENT	FROM	TO	SIZE	PUT IN	PULLED OUT

Describe in detail the manner in which the well was plugged, indicating where the mud fluid was placed and the method or methods used in introducing it into the hole. If cement or other plugs were used, state the character of same and depth placed, from _____ feet to _____ feet for each plug set.

Spotted 20 sacks cement @ 540'.
Spotted 20 sacks cement @ 240'.
Filled hole to 40' with rotary mud. Pushed wooden plug and hulls to fluid. Cemented with 10 sacks cement.
Job completed @ 8:45 a.m. 1/24/65.
Cemented by Sun Oil Well Cementing Co.

RECEIVED
STATE CORPORATION COMMISSION

FEB 5 1965
2-5-65
CONSERVATION DIVISION
Wichita, Kansas

(If additional description is necessary, use BACK of this sheet)

Name of Plugging Contractor _____

Address _____

STATE OF KANSAS, COUNTY OF BARTON, ss.

Charles W. Steincamp (employee of owner) or (owner or operator) of the above-described well, being first duly sworn on oath, says: That I have knowledge of the facts, statements, and matters herein contained and the log of the above-described well as filed and that the same are true and correct. So help me God.

(Signature) Charles W. Steincamp

2421 - 10th, Great Bend, Kansas
(Address)

SUBSCRIBED AND SWORN TO before me this 27th day of January, 1965

My commission expires Nov 14, 1965

Elaine N. Taylor
Notary Public.

DRILLER'S LOG

#1 Rollins

COMPANY: R. V. Lehner
 CONTRACTOR: Strata Drilling, Inc.
 COMMENCED: January 13, 1965
 COMPLETED: January 24, 1965
 DESCRIPTION: SW SW
 Section 13-T20S-R24W
 Ness County, Kansas

ELEVATION: 2285' DF
 2287' KB
 CASING RECORD: 6 jts. 8-5/8" 20#
 new pipe
 TOTAL DEPTH 4380'

D. & A.

<u>FORMATION</u>	<u>FROM</u>	<u>TO</u>	<u>REMARKS</u>
Clay	0	65	Spud 12 1/4" hole @ 4:15 P. M. 1-13-65. Ran 6 jts. 8-5/8" 20# new pipe. (269.92' overall tally) Set @ 277' with 185 sacks common cement, 2% gel and 3% calcium chloride. Plug down at 12:45 A. M. 1-14-65. Cement circulated.
Shale	65	279	
Shale & Shells	279	883	Ran two drill stem tests.
Gyp	883	904	
Shale & Shells	904	976	D. & A.
Sand	976	1182	
Shale	1182	1410	Hole plugged as follows: Plugged at 550' with 20 sacks of cement, plugged at 240' with 20 sacks of cement, plugged at 40' with 10 sacks of cement. Plug down at 8:45 A. M. January 24, 1965.
Shale & Red Bed	1410	1527	
Anhydrite	1527	1550	RTD
Shale & Red Bed	1550	1716	
Shale, Shells	1716	2106	
Shale & Lime	2106	2317	
Lime & Shale	2317	3730	
Lime	3730	3943	
Lime & Shale	3943	4019	
Lime	4019	4144	
Lime & Shale	4144	4195	
Lime	4195	4284	
Lime & Shale	4284	4325	
Lime, Chert	4325	4367	
Chert	4367	4370	
Chert & Lime	4370	4380	

RECEIVED
 STATE CORPORATION COMMISSION
 FEB 5 1965
 CONSERVATION DIVISION
 Wichita, Kansas

STATE OF KANSAS)
) SS.
 COUNTY OF BARTON)

I, the undersigned, being duly sworn on oath, state that the above statement and log are a true and a correct record of the well drilled at the location above described.

STRATA DRILLING, INC.

Charles W. Steincamp
 Charles W. Steincamp, President

Subscribed and sworn to before me this 27th day of January, 1965.

Elaine H. Taylor
 Elaine H. Taylor, Notary Public

My Commission Expires:
 December 14, 1965