


STATE OF KANSAS  
STATE CORPORATION COMMISSION

Form CP-4

WELL PLUGGING RECORD

Give All Information Completely  
Make Required Affidavit  
Mail or Deliver Report to:  
Conservation Division  
State Corporation Commission  
212 No. Market  
Wichita, Kansas

NORTH

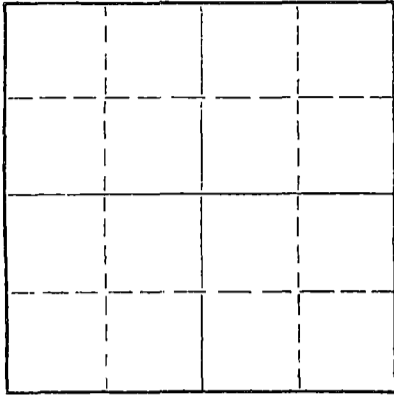

Locate well correctly on above  
Section Plat

Ness County, Sec. 13 Twp. 20S Rge. (E) 24 (W)  
Location as "NE/CNW/SW" or footage from lines C/SW SE  
Lease Owner R. V. Lehner  
Lease Name Rollins Well No. 3  
Office Address P. O. Box 398, Ness City, Kansas  
Character of Well (completed as Oil, Gas or Dry Hole) Dry Hole  
Date well completed July 24 19 66  
Application for plugging filed July 24 19 66  
Application for plugging approved July 24 19 66  
Plugging commenced July 24 19 66  
Plugging completed July 24 19 66  
Reason for abandonment of well or producing formation Dry Hole

If a producing well is abandoned, date of last production 19  
Was permission obtained from the Conservation Division or its agents before plugging was commenced? Yes

Name of Conservation Agent who supervised plugging of this well Leo F. Massey, Hays, Kansas  
Producing formation Depth to top Bottom Total Depth of Well 4415 Feet  
Show depth and thickness of all water, oil and gas formations.

OIL, GAS OR WATER RECORDS

CASING RECORD

FORMATION	CONTENT	FROM	TO	SIZE	PUT IN	PULLED OUT
	8-5/8"	0	302'			

Describe in detail the manner in which the well was plugged, indicating where the mud fluid was placed and the method or methods used in introducing it into the hole. If cement or other plugs were used, state the character of same and depth placed, from feet to feet for each plug set.

Plugged hole as follows: Plugged at 600' with 30 sacks of cement and mud to 280'; plugged at 280' with 20 sacks of cement and mud to 40'; plugged at 40' with 10 sacks of cement. 2 1/2 sacks of cement in rat hole and 2 1/2 sacks of cement in mouse hole. Plug down at 9:00 P. M. July 24, 1966.

RECEIVED  
STATE CORPORATION COMMISSION

JUL 29 1966

CONSERVATION DIVISION  
Wichita, Kansas

(If additional description is necessary, use BACK of this sheet)  
Name of Plugging Contractor Strata Drilling, Inc.  
Address P. O. Box 355, Great Bend, Kansas 67530

STATE OF KANSAS, COUNTY OF BARTON, ss.  
Charles W. Steincamp (employee of owner) or (owner/operator) of the above-described well, being first duly sworn on oath, says: That I have knowledge of the facts, statements, and matters herein contained and the log of the above-described well as filed and that the same are true and correct. So help me God.

(Signature) Charles W. Steincamp  
Charles W. Steincamp, President  
P. O. Box 355, Great Bend, Kansas  
(Address)

SUBSCRIBED AND SWORN TO before me this 27th day of July, 19 66

My commission expires December 14, 1969

Elaine H. Taylor  
Notary Public.

D R I L L E R S    L O G

#3 Rollins

CASING RECORD: 295' of new 8-5/8" surface casing.	COMPANY: R. V. Lehner	DESCRIPTION: C/SW SE Section 13-20S-24W Ness County, Kansas
TOTAL DEPTH: 4415'	CONTRACTOR: Strata Drilling, Inc.	ELEVATION: 2320' KB
	COMMENCED: July 17, 1966	
	COMPLETED: July 24, 1966	

D. & A.

<u>FORMATION</u>	<u>FROM</u>	<u>TO</u>	<u>REMARKS</u>
Clay	0	302	Ran 295' of new 8-5/8" surface casing; set and cemented at 302' with 200 sacks of regular cement, 2% gel and 3% calcium chloride. Plug down at 10:00 P. M. July 17, 1966. Cement circulated.
Shale	302	625	
Shale & Shells	625	1650	
Shale & Red Bed	1650	2180	
Lime & Shale	2180	2450	
Lime & Shale	2450	3350	
Shale, Lime & Chalk	3350	3495	
Lime & Shale	3495	4415	

Total Depth 4415'

RECEIVED  
STATE CORPORATION COMMISSION

JUL 29 1966

D. & A.

CONSERVATION DIVISION  
Wichita, Kansas

Plugged hole as follows: Plugged at 600' with 30 sacks of cement and mud to 280'; plugged at 280' with 20 sacks of cement and mud to 40'; plugged at 40' with 10 sacks of cement, 2½ sacks of cement in rat hole and 2½ sacks of cement in mouse hole. Plug down at 9:00 P. M. July 24, 1966.

STATE OF KANSAS )  
                          ) ss.  
COUNTY OF BARTON)

I certify that this is a true and correct copy of the above log to the best of my knowledge.

STRATA DRILLING, INC.

*Charles W. Steincamp*  
Charles W. Steincamp, President

Subscribed and sworn to before me this 27th day of July, 1966.

*Elaine H. Taylor*  
Elaine H. Taylor, Notary Public

My Commission Expires:

December 14, 1969