


Give All Information Completely  
Make Required Affidavit  
Mail or Deliver Report to:  
Conservation Division  
State Corporation Commission  
211 No. Broadway  
Wichita, Kansas

WELL PLUGGING RECORD

Stafford County. Sec. 27 Twp. 21S Rge. (E) 13 (W)

Location as "NE/CNW/SW" or footage from lines NW NE NW  
Lease Owner Abercrombie Drilling, Inc.  
Lease Name LINKE Well No. 1  
Office Address 801 Union Center, Wichita, Kansas, 67202  
Character of Well (completed as Oil, Gas or Dry Hole) Lost joint of surface pipe  
Date well completed in hole & had to move. January 14, 19 66  
Application for plugging filed January 14, 1966, verbally 19 66  
Application for plugging approved verbally January 14, 19 66  
Plugging commenced January 14, 19 66  
Plugging completed January 14, 19 66  
Reason for abandonment of well or producing formation lost joint of surface pipe

NORTH

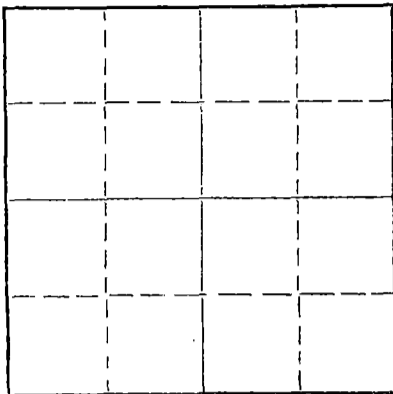

Locate well correctly on above  
Section Plat

If a producing well is abandoned, date of last production 19  
Was permission obtained from the Conservation Division or its agents before plugging was commenced? verbally - yes

Name of Conservation Agent who supervised plugging of this well Archie Elbing  
Producing formation Depth to top Bottom Total Depth of Well 2026 Feet  
Show depth and thickness of all water, oil and gas formations.

OIL, GAS OR WATER RECORDS

CASING RECORD

FORMATION	CONTENT	FROM	TO	SIZE	PUT IN	PULLED OUT
					247'	None

Describe in detail the manner in which the well was plugged, indicating where the mud fluid was placed and the method or methods used in introducing it into the hole. If cement or other plugs were used, state the character of same and depth placed, from feet to feet for each plug set.

Pushed plug to 200'  
Set 1st plug at 200' w/25 sx cement & 1/2 sk hulls.  
Set 2nd plug at 35' w/10 sx cement & 1/2 sk hulls.  
2 sx cement in rat hole.  
Job completed 4 P.M. 1-14-65.

RECEIVED  
STATE CORPORATION COMMISSION

JAN 19 1966

CONSERVATION DIVISION  
Wichita, Kansas

(If additional description is necessary, use BACK of this sheet)

Name of Plugging Contractor Abercrombie Drilling, Inc.  
Address 801 Union Center, Wichita, Kansas 67202

STATE OF Kansas, COUNTY OF Sedgwick, ss.  
I, Mildred Saxton (employee of owner) or (owner or operator) of the above-described well, being first duly sworn on oath, says: That I have knowledge of the facts, statements, and matters herein contained and the log of the above-described well as filed and that the same are true and correct. So help me, God.

(Signature) Mildred Saxton  
801 Union Center, Wichita, Kansas  
(Address)

SUBSCRIBED AND SWORN TO before me this 18th day of January, 19 66

Pran Jaye Neffe  
Notary Public.

My commission expires June 16, 1967

CONTRACTOR'S WELL LOG

COMPANY: Abercrombie Drilling, Inc.  
 CONTRACTOR: Abercrombie Drilling, Inc.  
 FARM: LINKE #1  
 LOCATION: NW NE NW Sec. 27-21S-13W  
 Stafford County, Kansas  
 COMMENCED: January 11, 1966  
 COMPLETED: January 14, 1966

0	110	Sand
110	140	Hard Sand
140	240	Shale
240	256	Shale
256	635	Shale & Sand
635	724	Shale
724	748	Anhydrite
748	1206	Shale
1206	1580	Shale & Shells
1580	1765	Shale
1765	2026	Shale & Shells
	2026	T. D.

Set 8-5/8" surface casing at 247' w/225 sx common cement, 3% CC.  
 Had to skid rig, because we lost a joint of surface pipe in hole.

TOPS: Anhydrite 724' ELEVATION: 1884' K. B.

RECEIVED  
 STATE CORPORATION COMMISSION

JAN 19 1966

CONSERVATION DIVISION

STATE OF KANSAS )  
 ) SS  
 COUNTY OF SEDGWICK )

I, Mildred Saxton, do hereby certify that the above and foregoing is a true and correct copy of the log of the LINKE #1, NW NE NW, Section 27-21S-13W, Stafford County, Kansas, as reflected by the files of Abercrombie Drilling, Inc.

*Mildred Saxton*  
 Mildred, Saxton, Secretary

Subscribed and sworn to before me, a Notary Public, in and for Sedgwick County, Kansas, this 18th day of January, 1966.

*Leah Faye Hefke*  
 Leah Faye Hefke, Notary Public

My commission expires June 16, 1967.