


Give All Information Completely
Make Required Affidavit
Mail or Deliver Report to:
Conservation Division
State Corporation Commission
212 No. Market
Wichita, Kansas

WELL PLUGGING RECORD

Stafford County, Sec. 27 Twp. 21 Rge. (E) 13(W)
Location as "NE/CNW%SW%" or footage from lines NE NE SW
Lease Owner The Bovaird Supply Company
Lease Name Sipes Well No. 3
Office Address P.O. Box 2590, Tulsa, Oklahoma
Character of Well (completed as Oil, Gas or Dry Hole) oil
Date well completed 19
Application for plugging filed November 11 1969
Application for plugging approved 19
Plugging commenced November 12 1969
Plugging completed November 24 1969
Reason for abandonment of well or producing formation depleted

NORTH

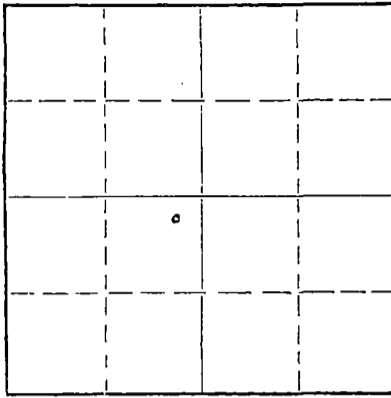

Locate well correctly on above
Section Plat

If a producing well is abandoned, date of last production 19
Was permission obtained from the Conservation Division or its agents before plugging was commenced? yes

Name of Conservation Agent who supervised plugging of this well Ralph Warren
Producing formation Depth to top Bottom Total Depth of Well 3704 Feet
Show depth and thickness of all water, oil and gas formations.

OIL, GAS OR WATER RECORDS

CASING RECORD

FORMATION	CONTENT	FROM	TO	SIZE	PUT IN	PULLED OUT
		0	248'	8 5/8"	248'	none
		0	3692'	5 1/2"	3692'	1885.79

Describe in detail the manner in which the well was plugged, indicating where the mud fluid was placed and the method or methods used in introducing it into the hole. If cement or other plugs were used, state the character of same and depth placed, from feet to feet for each plug set.

Pushed plug to 3340' and dumped 5 sacks of cement.

Squeezed well with 75 sacks of cement and 15 sacks gel mud.

RECEIVED
STATE CORPORATION COMMISSION
DEC 9 1969
CONSERVATION DIVISION
Wichita, Kansas

(If additional description is necessary, use BACK of this sheet)
Name of Plugging Contractor PIPE PULLERS, INC.
Address Box 486, Ellinwood, Kansas

STATE OF Kansas, COUNTY OF Barton, ss.
Evelyn Roth (employee of owner) or (owner or operator) of the above-described well, being first duly sworn on oath, says: That I have knowledge of the facts, statements, and matters herein contained and the log of the above-described well as filed and that the same are true and correct. So help me God.

(Signature) Evelyn Roth
Ellinwood, Kansas (Address)

SUBSCRIBED AND SWORN TO before me this 8th day of December, 1969

Scargel Meyer
Notary Public.

My commission expires Feb. 10, 1971


WELL LOG BUREAU KANSAS GEOLOGICAL SOCIETY
412 Union National Bk. Bldg. Wichita, Kansas

Company: LION OIL COMPANY
Farm: Sipes No. 3

SEC. 27 T. 21 R. 13W
CM/2 NE SW

Total Depth. 3704'
Comm. 9-21-48 Comp. 10-1-48
Shot or Treated. 1000 Acid
Contractor. R. W. Rine Drlg. Co.
Issued. 11-6-48

County. Stafford
KANSAS

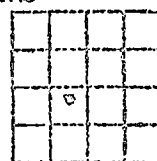

CASING:
8 5/8" 248' cem
5 1/2" 3692' cem.

Elevation. _____

Production. Est. 100 BOPD

Figures indicate Bottom of Formations.

sand and shells	240
shells	250
shale, redbed	700
shale and shells	725
anhydrite	745
shale and shells	1200
shale, salt, shells	1600
shale and lime	1965
lime	2115
lime and shale	2420
shale and shells	2595
shale and lime	2795
shale	2880
shale and lime	3055
lime	3245
shale and lime	3580
shale	3597
che rt	3640
shale and lime	3670
lime	3704
total depth	

Tops:

Lansing	3342'
Viola	3597
Simpson	3644
Arbuckle	3690

Drill deeper 3704' T.D.
1000 acid

Swab 12 BOPH
Est. 100 BOPD

RECEIVED
STATE CORPORATION COMMISSION
NOV 12 1969
CONSERVATION DIVISION
Wichita, Kansas