


Give All Information Completely  
Make Required Affidavit  
Mail or Deliver Report to:  
Conservation Division  
State Corporation Commission  
211 No. Broadway  
Wichita, Kansas

WELL PLUGGING RECORD

Stafford County, Se 27 Twp. 21 Rge. 13 (E) (W)

Location as "NE/CNW/SW" or footage from lines NE SW SW  
Lease Owner Lion Oil Company - Monsanto Chemical Co.  
Lease Name Gates #3 Well No. 3  
Office Address Box 580 Pratt, Kansas  
Character of Well (completed as Oil, Gas or Dry Hole) Oil  
Date well completed \_\_\_\_\_ 19\_\_\_\_  
Application for plugging filed July 30, 1962 19\_\_\_\_  
Application for plugging approved July 31, 1962 19\_\_\_\_  
Plugging commenced August 11, 1962 19\_\_\_\_  
Plugging completed August 15, 1962 19\_\_\_\_  
Reason for abandonment of well or producing formation Dry

NORTH

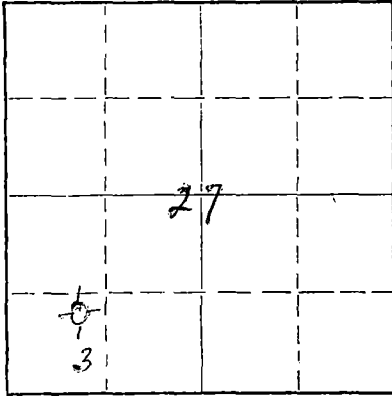

Locate well correctly on above Section Plat

If a producing well is abandoned, date of last production April, 1956 19\_\_\_\_  
Was permission obtained from the Conservation Division or its agents before plugging was commenced? Yes

Name of Conservation Agent who supervised plugging of this well W. L. Lackamp  
Producing formation \_\_\_\_\_ Depth to top \_\_\_\_\_ Bottom \_\_\_\_\_ Total Depth of Well 3360 Feet  
Show depth and thickness of all water, oil and gas formations.

OIL, GAS OR WATER RECORDS

CASING RECORD

FORMATION	CONTENT	FROM	TO	SIZE	PUT IN	PULLED OUT
				8 5/8	242	none
				5 1/2	none	2828

Describe in detail the manner in which the well was plugged, indicating where the mud fluid was placed and the method or methods used in introducing it into the hole. If cement or other plugs were used, state the character of same and depth placed, from \_\_\_\_\_ feet to \_\_\_\_\_ feet for each plug set.

Moved in and rigged up unit and jacks. Cleaned out cellar.

Measured T.D. and sanded to 3300'. Dumped 5 sacks cement and worked pipe and shot @2900'. Worked pipe and shot @2850', worked pipe and shot @2800'. Started pulling pipe.

Pulled pipe.

Plugged well with 15 sacks gel and 75 sacks cement.

RECEIVED  
STATE CORPORATION COMMISSION  
11-19-62  
NOV 17 1962  
CONSERVATION DIVISION  
Wichita, Kansas

(If additional description is necessary, use BACK of this sheet)

Name of Plugging Contractor Forbes Casing Pulling Inc.  
Address Box 221 Great Bend, Kansas

STATE OF Kansas COUNTY OF Barton, ss.  
J. O. Forbes (employee of owner) or (owner or operator) of the above-described well, being first duly sworn on oath, says: That I have knowledge of the facts, statements, and matters herein contained and the log of the above-described well as filed and that the same are true and correct. So help me God.

(Signature) J. O. Forbes  
Box 221 St Bend, Kas. (Address)

SUBSCRIBED AND SWORN to before me this 20 day of August, 1962

My commission expires April 8, 1965

Notary Public.



RECEIVED  
STATE CORPORATION COMMISSION

JUL 31 1962

CONSERVATION DIVISION  
Wichita, KansasLyon Oil Company  
El Dorado, Arkansas

Gates Well No. 3

C NE SW SW  
Sec. 27-21-13W  
Stafford County, KansasContractor: The R. W. Rine Drilling Company  
Started@ 10-5-48 Finished: 10-17-48Log

Sand, shells	0- 242	8 5/8" csg. cemented @ 242'
Shale, red bed	242- 560	
Shale, shells	560-1645	
Lime	1645-1965	
Lime, shale	1965-2120	
Lime	2120-2220	
Lime, shale	2220-2415	
Shale	2415-2605	
Shale, lime	2605-2730	
Lime	2730-2835	
Shale, lime	2835-3015	
Lime	3015-3324	
Shale, lime	3324-3404	
Lime	3404-3603	
Chert	3603-3641	
Cherty lime	3641-3650	
Shale, lime	3650-3690	
Lime	3690-3700	SLM corrected back to 3698'
		5 1/2" csg. cemented @ 3695'
		TD: 3698'

State of Kansas ) ss  
County of Sedgwick)

I, Clyde W. Goddard, do hereby certify that the above is a true and complete log of the Gates Well No. 3 located in the center of the NE/4 of the SW/4 of tthe SW/4 of Sec. 27-21-13W, Stafford County, Kansas.

*Clyde W. Goddard*  
Secretary

Sworn to and subscribed before me this 1st day of November, 1948.

My Commission Expires August 27, 1951

*Louetta Haney*  
Notary Public