

STATE OF KANSAS  
STATE CORPORATION COMMISSION


Give All Information Completely  
Make Required Entries  
Mail or Deliver Report to:  
Conservation Division  
State Corporation Commission  
211 No. Broadway  
Wichita, Kansas

WELL PLUGGING RECORD

Stafford County, Sec. 27 Twp. 21S Rge. 13W (E) (W)

Location as "NE/CNW/SW" or footage from lines. NW SE SW  
Lease Owner Lion Oil Company  
Lease Name Gates Well No. 2  
Office Address Box 580 Pratt, Kansas  
Character of Well (completed as Oil, Gas or Dry Hole) Oil  
Date well completed August 11, 1948 19  
Application for plugging filed July 30, 1962 19  
Application for plugging approved July 31, 1962 19  
Plugging commenced July 31, 1962 19  
Plugging completed August 5, 1962 19  
Reason for abandonment of well or producing formation Dry

NORTH

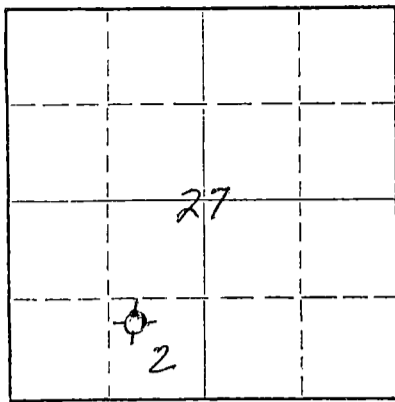

Locate well correctly on above Section Plat

If a producing well is abandoned, date of last production March 15, 1962 19  
Was permission obtained from the Conservation Division or its agents before plugging was commenced? Yes

Name of Conservation Agent who supervised plugging of this well W. L. Lackamp  
Producing formation \_\_\_\_\_ Depth to top \_\_\_\_\_ Bottom \_\_\_\_\_ Total Depth of Well 3720 Feet  
Show depth and thickness of all water, oil and gas formations.

OIL, GAS OR WATER RECORDS

CASING RECORD

FORMATION	CONTENT	FROM	TO	SIZE	PUT IN	PULLED OUT
				8 5/8	217	none
				5 1/2	none	2910

Describe in detail the manner in which the well was plugged, indicating where the mud fluid was placed and the method or methods used in introducing it into the hole. If cement or other plugs were used, state the character of same and depth placed, from \_\_\_\_\_ feet to \_\_\_\_\_ feet for each plug set.

Moved in and cleaned out cellar. Measured T.D. and sanded to 3380'. Dumped 5 sacks cement and rigged up jacks.

Cut off surface pipe and welded on collar. Shot @2900' and worked pipe. Shot @2852' and worked pipe. Shot @ 2822' and started pulling pipe.

Pulled pipe

Pulled pipe.

Pulled pipe and moved to Gates #4

Capped well with 15 sacks gel and 75 sacks cement.

RECEIVED  
STATE CORPORATION COMMISSION  
AUG 21 1962

CONSERVATION DIVISION  
WICHITA, KANSAS

(If additional description is necessary, use BACK of this sheet)

Name of Plugging Contractor Forbes Casing Pulling, Inc.  
Address Box 221 Great Bend, Kansas

STATE OF Kansas, COUNTY OF Barton, ss.  
J. O. Forbes (employee of owner) or (owner or operator) of the above-described well, being first duly sworn on oath, says: That I have knowledge of the facts, statements, and matters herein contained and the log of the above-described well as filed and that the same are true and correct. So help me God.

(Signature) J. O. Forbes  
Box 221 Great Bend, Kas. (Address)

SUBSCRIBED AND SWORN TO before me this 20 day of August, 1962.

My commission expires April 8, 1965

Notary Public.



Lion Oil Company  
El Dorado, Arkansas

Gates No. 2 Well

NW SE SW

Sec. 27-21-13

Stafford County, Kansas

Started: 7-24-48

Finished: 8- 5-48

Log

Surface sand, clay	0- 250	8 5/8" csg. cemented @ 247'
Red bed, shale	250- 670	
Shale, shells	670- 725	
Anhydrite	725- 750	
Shale, shells	750-1480	
Salt, shells	1480-1530	
Shale, shells	1530-1770	
Lime, shale	1770-1845	
Lime	1845-1930	
Lime, shale	1930-2385	
Shale, shells	2385-2585	
Shale	2585-2860	
Lime	2860-2900	
Shale, shells	2900-3020	
Lime, shale	3020-3110	
Lime	3110-3195	
Shale, shells	3195-3270	
Lime, shale	3270-3340	
Lime	3340-3386	
Lime, shale	3386-3439	
Lime	3429-3625	
Chert	3625-3640	
Lime	3640-3702	5 1/2" csg. cemented 3702'

RECEIVED  
STATE CORPORATION COMMISSION

JUL 31 1962

CONSERVATION DIVISION  
Wichita, Kansas

TD: 3702'

State of Kansas )  
County of Sedgwick) ss

I, E. H. Sloyer, do hereby certify that the above is a true and complete log of the Gates Well No. 2 located in the NW/4 of the SE/4 of the SW/4 of Sec. 27-31-13, Stafford County, Kansas.

E. H. Sloyer  
Assistant Secretary

Sworn to and subscribed before me this 23rd of August, 1948.

My Commission Expires August 27, 1951

Loretta Hancy  
Notary Public