


WELL PLUGGING RECORD

Give All Information Completely  
Make Required Affidavit  
Mail or Deliver Report to:  
Conservation Division  
State Corporation Commission  
800 Bittling Building  
Wichita, Kansas

Stafford County, Sec. 27 Twp 21S Rge. (E) 13 (W)

Location as "NE/CNW $\frac{1}{4}$ SW $\frac{1}{4}$ " or footage from lines N W SW SE  
Lease Owner The Atlantic Refining Company  
Lease Name Gates Well No. 14  
Office Address Box 17, Great Bend, Kansas  
Character of Well (completed as Oil, Gas or Dry Hole) Dry Hole  
Date well completed 11-23-51 19  
Application for plugging filed 1-4-52 19  
Application for plugging approved 1-7-52 19  
Plugging commenced 2-15-52 19  
Plugging completed 3-7-52 19  
Reason for abandonment of well or producing formation Dry hole

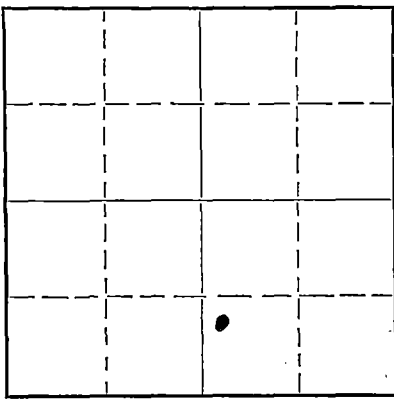

Locate well correctly on above Section Plat

If a producing well is abandoned, date of last production 19  
Was permission obtained from the Conservation Division or its agents before plugging was commenced? yes

Name of Conservation Agent who supervised plugging of this well G. D. Stough  
Producing formation Depth to top Bottom Total Depth of Well 3713 Feet  
Show depth and thickness of all water, oil and gas formations.

OIL, GAS OR WATER RECORDS

CASING RECORD

Formation	Content	From	To	Size	Put In	Pulled Out
				8-5/8"	212'	0
				5-1/2"	3698'	2547'

Describe in detail the manner in which the well was plugged, indicating where the mud fluid was placed and the method or methods used in introducing it into the hole. If cement or other plugs were used, state the character of same and depth placed, from feet to feet for each plug set.

Mud and sand 3486' to 3465'  
5 sacks cement 3465' to 3456'  
Mud 3456' to 212'  
Rock bridge 212' to 200'  
15 sacks cement 200' to 185'  
Mud 185' to 35'  
Rock bridge 35' to 20'  
5 sacks cement 20' to 10'

(If additional description is necessary, use BACK of this sheet)

Correspondence regarding this well should be addressed to Box 17, Great Bend, Kansas  
Address The Atlantic Refining Company

STATE OF Kansas, COUNTY OF Barton, ss.

(employee of owner) or (owner or operator) of the above-described well, being first duly sworn on oath, says: That I have knowledge of the facts, statements, and matters herein contained and the log of the above-described well as filed and that the same are true and correct. So help me God.

(Signature) Stanton X. Meyer  
Box 17, Great Bend, Kansas  
(Address)

SUBSCRIBED AND SWORN to before me this 11th day of March, 19 52

Jeta B. Love  
Notary Public.

My commission expires 7-29-55

28-5091-s 8-50-10M

PLUGGING  
FILE SEC 27 T 21 R 130  
PAGE 135 LINE 41

MAR 12 1952 3-12-52  
KANSAS STATE CORPORATION COMMISSION  
WICHITA, KANSAS

THE ATLANTIC REFINING COMPANY  
830 Kennedy Building  
Tulsa 3, Oklahoma

KS-3818-19

Elevation: 1882 DF  
1879.7' GL  
1884.35' RKB

GATES POOL

WELL LOG

GATES #14

NW SW SE of 27-21S-13W,  
Stafford County, Kansas.

SPUDED: 11-11-51

Casing Record:

REACHED T.D.: 11-23-51

212.46' of 8-5/8" OD 8V thd. 28# casing  
set at 222' RKB w/250 sacks sulfate re-  
sistant cement with 1/4 of 1% calcium  
chloride.

DRY HOLE

Set 3698.55' of 5 1/2" OD 8 rd. thd. 14#  
casing at 3707' w/250 sax Star Core sulphate  
resistant cement.

FORMATION RECORD

<u>FORMATION</u>	<u>TOP</u>	<u>BOTTOM</u>
Sand & clay	0	170
Shale & shells	170	265
Red beds	265	630
Shale & lime	630	785
Red bed, shale & shells	785	1180
Shale & shells	1180	1210
Salt	1210	1265
Shale & shells	1265	1475
Lime & shale	1475	1690
Lime	1690	2065
Shale & lime	2065	2095
Lime	2095	2180
Shale & lime	2180	2325
Shale & lime shells	2325	2485
Shale & shells	2485	2680
Lime	2680	2770
Shale & lime	2770	2910
Lime & shale	2910	3125
Lime	3125	3255
Shale & lime	3255	3325
Lime & shale	3325	3339
Lime	3339	3540
Lime & shale	3540	3605
Lime & chert	3605	3653
Shale & lime	3653	3696
Lime & chert	3696	3706
Lime	3706	3713 T.D.
		3486 P.B.D.

To P&A.

JAN -7 1952  
CONSERVATION DIVISION  
Mineral Resources

PLUGGING  
FILE NO. 27 21 S 13 W  
PAGE 135 OF 41