


Give All Information Completely
Make Required Affidavit
Mail or Deliver Report to:
Conservation Division
State Corporation Commission
P. O. Box 17027
Wichita, Kansas 67217
NORTH

WELL PLUGGING RECORD

Ness County, Sec. 9 Twp. 20S Rge. (E) 24(W)
Location as "NE/CNW/SW" or footage from lines C/NW NE
Lease Owner R. T. McCreight
Lease Name McCreight Well No. 2
Office Address 112 East Main, Ness City, Kansas 67560
Character of Well (completed as Oil, Gas or Dry Hole) Dry Hole
Date well completed February 15 1975
Application for plugging filed February 15 1975
Application for plugging approved February 15 1975
Plugging commenced February 15 1975
Plugging completed February 15 1975
Reason for abandonment of well or producing formation Dry Hole

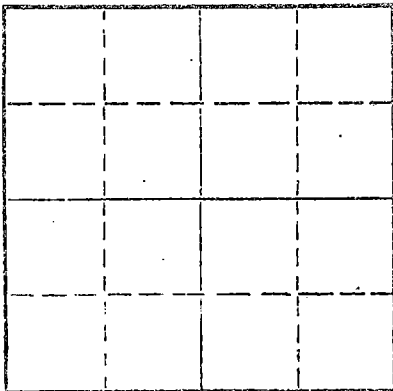

Locate well correctly on above Section Plat

If a producing well is abandoned, date of last production 19
Was permission obtained from the Conservation Division or its agents before plugging was commenced? Yes

Name of Conservation Agent who supervised plugging of this well Leo Massey, Hays, Kansas
Producing formation _____ Depth to top _____ Bottom _____ Total Depth of Well 4434 Feet
Show depth and thickness of all water, oil and gas formations.

OIL, GAS OR WATER RECORDS

CASING RECORD

FORMATION	CONTENT	FROM	TO	SIZE	PUT IN	PULLED OUT
	8-5/8"	0'	320'			

Describe in detail the manner in which the well was plugged, indicating where the mud fluid was placed and the method or methods used in introducing it into the hole. If cement or other plugs were used, state the character of same and depth placed, from _____ feet to _____ feet for each plug set.

Hole plugged as follows: Plugged at 600' with 70 sacks of 50-50 pozmix & 6% gel; plugged at 240' with 20 sacks of 50-50 pozmix & 6% gel; plugged at 40' with 10 sacks of 50-50 pozmix and 6% gel. Plug down at 11:30 A. M. February 15, 1975.

RECEIVED
STATE CORPORATION COMMISSION

15-312435 2-24-75


CONSERVATION DIVISION
Wichita, Kansas

(If additional description is necessary, use BACK of this sheet)
Name of Plugging Contractor Strata Drilling Company
Address P. O. Box 355, Great Bend, Kansas 67530

STATE OF KANSAS, COUNTY OF BARTON ss.
Kenneth J. Link (employee of owner) or (owner or operator) of the above-described well, being first duly sworn on oath, says: That I have knowledge of the facts, statements, and matters herein contained and the log of the above-described well as filed and that the same are true and correct. So help me God.

(Signature) Kenneth J. Link
Kenneth J. Link, President
P. O. Box 355, Great Bend, Kansas 67530
(Address)

Subscribed and sworn to before me this 17th day of February, 1975.
My commission expires December 14, 1977

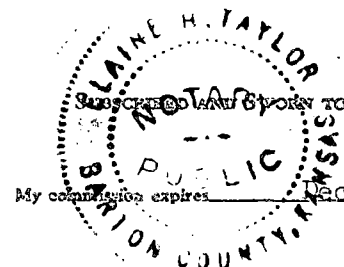

Elaine H. Taylor
Notary Public

DRILLERS LOG

#2 McCreight

CASING: 313.97' of used 8-5/8" surface casing. COMPANY: R. T. McCreight DESCRIPTION: C/NW NE Section 9-20S-24W Ness City, Kansas
 CONTRACTOR: Strata Drilling Company
 TOTAL DEPTH: 4434' COMMENCED: February 6, 1975
 COMPLETED: February 15, 1975

D. & A.

FORMATION	FROM	TO	REMARKS
Surface Soil & Clay	0	270	Ran 313.97' of used 8-5/8" surface casing; set and cemented at 320' with 200 sacks of common cement, 2% gel and 3% C. C. Plug down at 2:30 A. M. February 7, 1975.
Surface Soil & Clay	270	335	
Shells, Shale w/Sand Streaks	335	740	
Shale & Red Bed	740	984	
Anhydrite	984	998	
Sand & Red Bed	998	1410	
Red Bed & Shale	1410	1985	
Shale w/Lime	1985	2240	
Shale & Lime	2240	4035	
Lime	4035	4140	
Lime & Shale	4140	4236	
Lime	4236	4255	
Lime & Shale	4255	4434	

ROTARY TOTAL DEPTH: 4434'

Ran electric log.

D. & A.

Hole plugged as follows: Plugged at 600' with 70 sacks of 50-50 pozmix & 6% gel; plugged at 240' with 20 sacks of 50-50 pozmix & 6% gel; plugged at 40' with 10 sacks of 50-50 pozmix & 6% gel. Plug down at 11:30 A. M. February 15, 1975.

RECEIVED
 STATE CORPORATION COMMISSION
 1-30-1975
 CONSERVATION DIVISION
 Wichita, Kansas

STATE OF KANSAS)
) ss.
 COUNTY OF BARTON)

I certify that this is a true and correct copy of the above log to the best of my knowledge.

STRATA DRILLING COMPANY

Kenneth J. Link
 Kenneth J. Link, President

Subscribed and sworn to before me this 17th day of February, 1975.

My Commission Expires:

Elaine H. Taylor
 Elaine H. Taylor, Notary Public

