

STATE OF KANSAS
STATE CORPORATION COMMISSION


Give All Information Completely
Make Required Affidavit
Mail or Deliver Report to:
Conservation Division
State Corporation Commission
211 No. Broadway
Wichita, Kansas

WELL PLUGGING RECORD

Stafford County. Sec. 26 Twp. 21 Rge. (E) 12 (W)

Location as "NE/CNW/SW" or footage from lines NW SW SW
Lease Owner Thos. H. Allan & Cooperative Refinery Association
Lease Name William Siefkes Well No. 1
Office Address 925 Union Center, Wichita 2, Kansas
Character of Well (completed as Oil, Gas or Dry Hole) Dry Hole
Date well completed January 12 1959
Application for plugging filed January 12 1959
Application for plugging approved January 12 1959
Plugging commenced January 12 1959
Plugging completed January 12 1959
Reason for abandonment of well or producing formation Dry Hole

NORTH

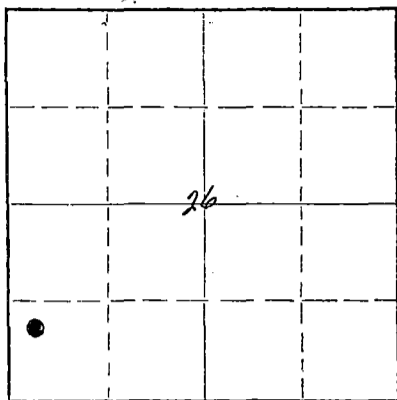

Locate well correctly on above Section Plat

If a producing well is abandoned, date of last production 19
Was permission obtained from the Conservation Division or its agents before plugging was commenced? Yes

Name of Conservation Agent who supervised plugging of this well
Producing formation ^{not reached,} due sink hole Depth to top Bottom Total Depth of Well 364.6 Feet
Show depth and thickness of all water, oil and gas formations.

OIL, GAS OR WATER RECORDS

CASING RECORD

FORMATION	CONTENT	FROM	TO	SIZE	PUT IN	PULLED OUT
				8 5/8	264'	None

Describe in detail the manner in which the well was plugged, indicating where the mud fluid was placed and the method or methods used in introducing it into the hole. If cement or other plugs were used, state the character of same and depth placed, from feet to feet for each plug set.

364.6 - 250 Heavy Mud
250 - 175 Bridge of 1/3 sack of hulls, and 25 sacks of cement
175 - 40 Heavy Mud
40 - Surface Bridge of 1/3 sack of hulls, and 10 sacks of cement

1-20-59
RECEIVED
STATE CORPORATION COMMISSION
JAN 28 1959

(If additional description is necessary, use BACK of this sheet)

Name of Plugging Contractor Thos. H. Allan
Address 925 Union Center, Wichita 2, Kansas

STATE OF KANSAS, COUNTY OF SEDGWICK, ss.
Thos. H. Allan (employee of owner) or (owner or operator) of the above-described well, being first duly sworn on oath, says: That I have knowledge of the facts, statements, and matters herein contained and the log of the above-described well as filed and that the same are true and correct. So help me God.

(Signature) Thos. H. Allan
925 Union Center, Wichita 2, Kansas
(Address)

SUBSCRIBED AND SWORN TO before me this 16th day of January, 1959

Ocie M. Stewart
Notary Public.

My commission expires June 14, 1962

PLUGGING
FILE SEC 26 T. 21 R. 12 W
BOOK PAGE 11 LINE 12

15.185.19563.0000

ALLAN & C.R.A. #1 William Siefkes
 NW SW SW 26-21-12W
 Max Pool, Stafford Col, Kansas
 COMM: 1/3/59 COMPL: 1/12-59
 CONTRACTER: Tom Allan
 Elev: 1843 RB

I.P. D & A

All Depths From Rotary Bushings

0 - 40 Sandy Soil
 60 Yellow Clay
 150 Coarse Gravel
 180 Yellow Clay
 264 Red Beds
 226 Red Shale
 232 Anhydrite (thin)
 900 Red Shale
 1100 Shale
 1400 Salt & Shale
 1500 Anhydrite
 1600 Lime Shells
 1700 Shale & Lime
 1800 Lime
 1842 Dolomite
 1872 Cherty Fosuliferous Lime
 1884 Red Shale
 2850 Shale & Shells
 3122 Lime & Shale Breaks
 3126 Black Shale
 3129 Hard Buff Lime
 3140 Shale
 3153 Lime
 3252 Shale & Sandy Shales
 3258 Lime, Brown
 3272 Shale
 3289 Lime
 3292 Dark Shale
 3327 Lime
 3331 Shale
 3360 Lime
 3365 Soft Oolitic Lime
 3395 Lime
 3400 Shale
 3455 Lime
 3458 Shale
 3463 Oolitic, slight show dk oil
 3487 Lime
 3496 Shale & Lime
 3503 Lime
 3508 Shale
 3511 Lime
 3520 Shale
 3646 Red Mud, little Chert

FORMATION TOPS

626-632 (-1217) ANHYDRITE
 1872 (-29) BASE FLORENCE FLINT
 3122 (-1279) HEEBNER
 3252 (-1409) BROWN LIME
 3272 (-1429) LANSING
 3520 (-1677) CONGLERMATE SHALE

I certify that this is a true and correct copy of the well log.

Thomas H. Allan

Subscribed and sworn to before me this 16th day of January, 1959.

Ocie M. Stewart

RECEIVED
 STATE COMMISSION

JAN 20 1959

PLUGGING		
FILE	SEC 26 T 21 R 12W	
BOOK	PAGE 11	LINE 12