


STATE OF KANSAS  
STATE CORPORATION COMMISSION

WELL PLUGGING RECORD

Give All Information Completely  
Make Required Affidavit  
Mail or Deliver Report to  
Conservation Division  
State Corporation Comm.  
245 North Water  
Wichita, KS 67202

Stafford County, Sec. 26 Twp. 21 Rge. 12  $\frac{1}{2}$ W  
Location as "NE/CNW $\frac{1}{4}$ SW $\frac{1}{4}$ " or footage from lines  
C W/2 W/2 SE

Lease Owner L. D. Davis  
Lease Name WIDENER "B" Well No. 1  
Office Address Rt #1, Box 183B, Great Bend, KS 67530  
Character of Well (Completed as Oil, Gas or Dry Hole)  
Dry Hole

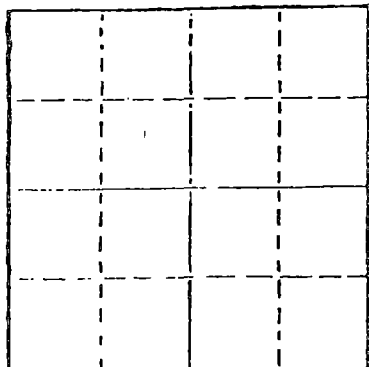

Locate well correctly on above  
Section Plat

Date Well completed March 18, 1983  
Application for plugging filed March 18, 1983  
Application for plugging approved March 18, 1983  
Plugging commenced 8:30 P.M. March 18, 1983  
Plugging completed 9:30 P.M. March 18, 1983  
Reason for abandonment of well or producing formation

If a producing well is abandoned, date of last production 19

Was permission obtained from the Conservation Division or  
its agents before plugging was commenced? yes

Name of Conservation Agent who supervised plugging of this well Paul Luthey  
Producing formation Depth to top Bottom Total Depth of Well 3630'  
Show depth and thickness of all water, oil and gas formations.

OIL, GAS OR WATER RECORDS

CASING RECORD

FORMATION	CONTENT	FROM	TO	SIZE	PUT IN	PULLED OUT

Describe in detail the manner in which the well was plugged, indicating where the mud fluid  
was placed and the method or methods used in introducing it into the hold. If cement or other  
plugs were used, state the character of same and depth placed, from feet to  
feet for each plug set.

35 SX @ 620'  
35 SX @ 360'  
10 SX @ 40'  
10 SX in the Rat Hole

(If additional description is necessary, use BACK of this sheet)

Name of Plugging Contractor L. D. Drilling, Inc.


STATE OF KANSAS COUNTY OF BARTON, ss.  
Don Popp (employee of owner) or (owner/contractor)

of the above-described well, being first duly sworn on oath, says: That I have knowledge of  
the facts, statements, and matters herein contained and the log of the above-described well  
as filed and that the same are true and correct. So help me God.

(Signature)

Don Popp, Hoisington, KS 67544  
(Address)

SUBSCRIBED AND SWORN TO before me this 18th day of March, 1983.

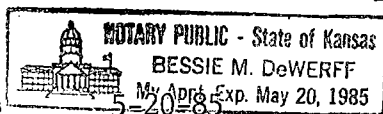

My commission expires

Bessie M. DeWerff Notary Public.

RECEIVED  
STATE CORPORATION COMMISSION

MAR 28 1983

CONSERVATION DIVISION  
Wichita, Kansas