


Give All Information Completely
Make Required Affidavit
Mail or Deliver Report to:
Conservation Division
State Corporation Commission
P. O. Box 17027
Wichita, Kansas 67217
NORTH

WELL PLUGGING RECORD

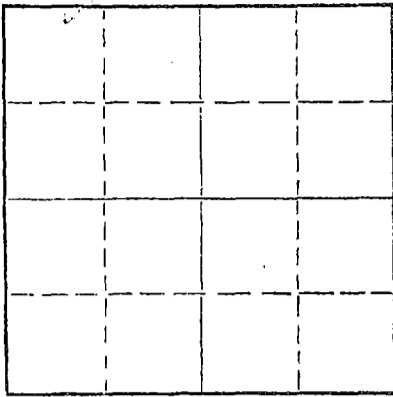

Locate well correctly on above Section Plat

Stafford County. Sec. 26 Twp. 21S Rge. 12W (E) (W) X
Location as "NE/CNW/SW" or footage from lines SE SW SE
Lease Owner Utica Southern Exploration, Inc.
Lease Name Widener Well No. 1
Office Address 503 Mayo Building, Tulsa, Oklahoma 74103
Character of Well (completed as Oil, Gas or Dry Hole) D&A
Date well completed November 20 19 73
Application for plugging filed November 20 19 73
Application for plugging approved November 20 19 73
Plugging commenced November 20 19 73
Plugging completed November 20 19 73
Reason for abandonment of well or producing formation D&A

If a producing well is abandoned, date of last production 19
Was permission obtained from the Conservation Division or its agents before plugging was commenced? Yes

Name of Conservation Agent who supervised plugging of this well Mr. G.R. Biberstein
Producing formation Depth to top Bottom Total Depth of Well 3,627 Feet
Show depth and thickness of all water, oil and gas formations.

OIL, GAS OR WATER RECORDS

CASING RECORD

FORMATION	CONTENT	FROM	TO	SIZE	PUT IN	PULLED OUT
				8-5/8"	296'	-0-

Describe in detail the manner in which the well was plugged, indicating where the mud fluid was placed and the method or methods used in introducing it into the hole. If cement or other plugs were used, state the character of same and depth placed, from feet to feet for each plug set.

Plug @ 600' w/40 sx.
Plug @ 275' w/25 sx.
Plug @ 40' w/1/4 sk. hulls & 15 sx. cmt.

RECEIVED
STATE CORPORATION COMMISSION
DEC 26 1973
CONSERVATION DIVISION
Wichita, Kansas

(If additional description is necessary, use BACK of this sheet)
Name of Plugging Contractor Red Tiger Drilling Company
Address 1720 Wichita Plaza, Wichita, Kansas 67202

STATE OF Kansas, COUNTY OF Sedgwick, ss.
Linda H. Dickens (employee of owner) or (owner or operator) of the above-described well, being first duly sworn on oath, says: That I have knowledge of the facts, statements, and matters herein contained and the log of the above-described well as filed and that the same are true and correct. So help me God.

(Signature) Linda H. Dickens
1720 Wichita Plaza, Wichita, Kansas 67202
(Address)

SUBSCRIBED AND SWORN TO before me this 27th day of November, 19 73

My commission expires May 24, 1977
LINDA C. MOWREY
NOTARY PUBLIC
SEDGWICK CO., KANS.

Linda C. Mowrey
Notary Public.

DRILLERS LOG

No. 1 Widener

CASING RECORD:	COMPANY:	DESCRIPTION:
8-5/8" @ 296'	Utica Southern Exploration	SE SW SE
w/275 sx cement	CONTRACTOR: Red Tiger Drilling Co.	26-21S-12W
	COMMENCED: November 12, 1973	Stafford County,
		Kansas
TOTAL DEPTH: 3,627'	COMPLETED: November 20, 1973	

ELEVATION:

<u>FORMATION</u>	<u>FROM</u>	<u>TO</u>	<u>REMARKS</u>
Sand	0	140	
Shale & Redbed	140	296	
Shale	296	350	
Shale & Shells	350	609	
Anhydrite	609	620	
Shale & Shells	620	1160	
Shale & Lime Streaks	1160	1595	
Lime & Shale Streaks	1595	1750	
Lime & Shale	1750	3250	
Lime	3250	3485	
Lime & Conglomerate	3485	3550	
Lime	3550	3595	
Shale & Lime	3595	3627	

RECEIVED
STATE CORPORATION COMMISSION
DEC 26 1973
CONSERVATION DIVISION
Wichita, Kansas

I certify that this is a true and correct copy of the above log to the best of my knowledge.

RED TIGER DRILLING COMPANY

Linda H. Dickens
Linda H. Dickens

Subscribed and sworn to before me this 27th day of November, 1973.

Linda C. Mowrey
Notary Public

My Commission Expires:

May 24, 1977

