


Give All Information Completely  
Make Required Affidavit  
Mail or Deliver Report to:  
Conservation Division  
State Corporation Commission  
211 No. Broadway  
Wichita, Kansas

WELL PLUGGING RECORD

STAFFORD County. Sec. 26 Twp. 21S Rge. 12 (E) (W) W

Location as "NE/CNW/SW" or footage from lines SW NW NW  
Lease Owner GEORGE A REED  
Lease Name WIDENER  
Office Address 1301 UNION NATIONAL BLDG., WICHITA, KANSAS  
Character of Well (completed as Oil, Gas or Dry Hole) DRY HOLE  
Date well completed 12/2 19 65  
Application for plugging filed 12/2 19 65  
Application for plugging approved 12/2 19 65  
Plugging commenced 12/2 19 65  
Plugging completed 12/2 19 65  
Reason for abandonment of well or producing formation TOO LOW STRUCTURALLY

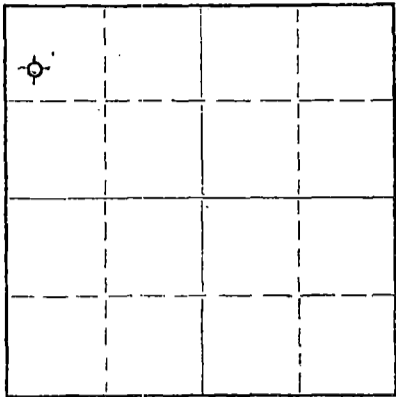

Locate well correctly on above Section Plat

If a producing well is abandoned, date of last production 19  
Was permission obtained from the Conservation Division or its agents before plugging was commenced? YES

Name of Conservation Agent who supervised plugging of this well ARCHIE V. ELVING  
Producing formation \_\_\_\_\_ Depth to top \_\_\_\_\_ Bottom \_\_\_\_\_ Total Depth of Well \_\_\_\_\_ Feet  
Show depth and thickness of all water, oil and gas formations.

OIL, GAS OR WATER RECORDS

CASING RECORD

FORMATION	CONTENT	FROM	TO	SIZE	PUT IN	PULLED OUT
				8-5/8"	279.71	NONE

Describe in detail the manner in which the well was plugged, indicating where the mud fluid was placed and the method or methods used in introducing it into the hole. If cement or other plugs were used, state the character of same and depth placed, from \_\_\_\_\_ feet to \_\_\_\_\_ feet for each plug set.

Filled with heavy mud to 250 ft. Set plug. Put in 25 sacks cement. Filled w/heavy mud to 40'. Set plug. Filled to top w/1/2 sacks hulls and 12 sacks cement.

RECEIVED  
STATE CORPORATION COMMISSION  
DEC 14 1965  
CONSERVATION DIVISION  
Wichita, Kansas

(If additional description is necessary, use BACK of this sheet)  
Name of Plugging Contractor C-G DRILLING CO.  
Address 107 RULE BUILDING, WICHITA 2, KANSAS

STATE OF KANSAS, COUNTY OF SEDGWICK, ss.  
G. F. GALLOWAY (employee of owner) or ~~owner or operator~~ of the above-described well, being first duly sworn on oath, says: That I have knowledge of the facts, statements, and matters herein contained and the log of the above-described well as filed and that the same are true and correct. So help me God.  
(Signature) G. F. Galloway  
107 Rule Building  
(Address)

Subscribed and sworn to before me this 7th day of December 19 65  
My commission expires May 20, 1967  
Vicky Jacobs  
Notary Public.



W E L L      L O G

OPERATOR: GEORGE A. REED

WELL NAME: WIDENER #1      LOCATION: SW NW NW Sec 26-21S-12W

COUNTY: STAFFORD      STATE: KANSAS

WELL COMMENCED: Nov. 22, 1965      WELL COMPLETED: DEC. 2, 1965

ELEVATION: 1841 KB      TOTAL DEPTH: 3641'

PRODUCTION: DRY & ABANDONED      RIG NO: #1

CASING - 8-5/8": 8 JOINTS, 279.71' W/287 SX QUIKSET  
 5-1/2": \_\_\_\_\_

All Measurements taken from the top of rotary bushing.

FROM	TO	FORMATION	DEVIATION FROM VERTICAL	REMARKS:
0	220	SAND	1/4 500'	
220	609	RED BED		
609	650	ANHYDRITE	1/4 1000'	
650	1530	SHALE - SHELLS	1 1500'	
1530	3350	LIME - SHALE	1 1/4 1970'	
3350	3610	LIME	3/4 3000'	DST #1 3485-3515'
3610	3641	ARBUCKLE		DST #2 3590-3610'
				MISRUN
				DST #3 3599-3630'

RECEIVED  
 STATE CORPORATION COMMISSION

DEC 14 1965

CONSERVATION DIVISION  
 Wichita, Kansas

STATE OF KANSAS )  
 COUNTY OF SEDGWICK ) SS:

The undersigned hereby certifies that to the best of his knowledge and belief, the above facts are true and correct.

C-G DRILLING CO.

By *[Signature]*



SUBSCRIBED AND SWORN TO, BEFORE ME, This 6 day of Dec., 1965.

My comm. exp: May 20, 1967

*[Signature]*  
 Vicky Jacobs - Notary Public